

LAUD. MISSISSIPPI BOARD OF WATER COMMISSIONERS

B12  
8-31-63

WATER WELL DRILLERS LOG

Date: 8.31, 1963, Driller: M. C. Donald of Hill County Lumberville, Inc.  
(Name)


(1) Owner of Land: F. T. BROWN  
(Name)  
Rt. #1, Baylag, Miss  
(Address)  
(2) Location: 35 8N 15E  
35 T R  
6 miles North of Meridian  
(distance) (direction) (Nearest Town)  
(3) Topography: X  
(Hilly) (Flat) (Level)  
(4) Purpose of Well: DOMESTIC  
(Domestic Irrigation  
Municipal, Industrial, Other)

Description & Color of Materials Sand, Clay, Red Clay, Shell, etc.	Thick- ness Feet	Depth Feet
CLAY	0	20
SANDY CLAY	20	50
SHALE	50	170
SOFT SHALE LIGNITE	170	200
SHALE	200	330
SAND	330	350
SANDY SHALE	350	375

Information upon completion of well:

(1) Diameter 4" inches.  
(2) Total Depth 375' feet.  
(3) Water Level 126' feet below top of ground.  
(4) Cased to 210, Size 4"  
(5) Screen: Size \_\_\_\_\_, Length \_\_\_\_\_  
(6) Were any formations sealed against pollution?  
\_\_\_\_\_ yes, \_\_\_\_\_ no.

If YES depth of formation \_\_\_\_\_  
Why \_\_\_\_\_  
Drillers Remarks: \_\_\_\_\_

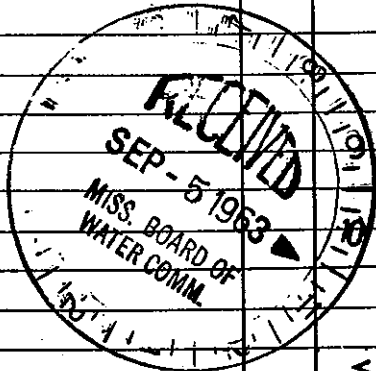

Well No.

(Use Back Side)

Mail this copy to Board of Water Commissioners 429 Miss. St. Jackson, Miss