

B 13

8-3-64

WATER WELL DRILLERS LOG

Date: 8/3, 1964, Driller: Bob Williams County Lauderdale
(Name)

(1) Owner of Land: Wilkie Emerson
(Name)
Bailey, Miss.
(Address)

(2) Location: $\frac{1}{4}$, $\frac{1}{4}$, Sec. 14 8N 15E T. R.
12 miles North, of Meridian
(distance) (direction) (Nearest Town)

(3) Topography: Hilly
(Hilly) (Flat) (Level)

(4) Purpose of Well: Domestic
(Domestic Irrigation
Municipal, Industrial, Other)

Description & Color of Materials Sand, Clay, Red Clay, Shell, etc.	Thick- ness Feet	Depth Feet
<u>Blue clay</u>	<u>80</u>	<u>1-80</u>
<u>fine gray sand</u>	<u>10</u>	<u>80-90</u>
<u>Blue clay</u>	<u>20</u>	<u>90-110</u>
<u>gray sand</u>	<u>10</u>	<u>110-120</u>
<u>Blue clay</u>	<u>130</u>	<u>120-250</u>
<u>gray sand</u>	<u>25</u>	<u>250-275</u>

Information upon completion of well:

(1) Diameter 2 inches.

(2) Total Depth 275 feet.

(3) Water Level 67 feet below top of ground.

(4) Cased to 10', Size 2 in.


(5) Screen: Size 0, Length _____

(6) Were any formations sealed against pollution?
✓ yes, _____ no.

If YES depth of formation _____

Why surface water

Drillers Remarks: _____

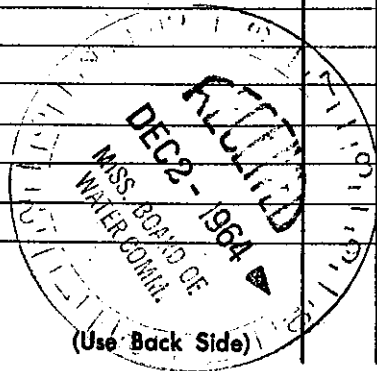

Well No. _____

Retain this copy for your office files.