

LAUD.
B 14

WATER WELL DRILLERS LOG

Date: 9-4-64, 1964, Driller: Bob Williamson County Laud.
(Name)

(1) Owner of Land: Willie Hodge
(Name)
Bailey, Miss.
(Address)
(2) Location: W 1/2 SE 1/4 SW - E 1/2 NESW
7 9 15
10 miles North of Meridian
(distance) (direction) (Nearest Town)

(3) Topography: Hilly
(Hilly) (Flat) (Level)

(4) Purpose of Well: Domestic
(Domestic Irrigation
Municipal, Industrial, Other)

Description & Color of Materials Sand, Clay, Red Clay, Shell, etc.	Thick- ness Feet	Depth Feet
<u>Red clay</u>	<u>15</u>	<u>1-15</u>
<u>gray sand</u>	<u>10</u>	<u>15-25</u>
<u>Blue Clay</u>	<u>235</u>	<u>25-260</u>
<u>fine gray sand</u>	<u>45</u>	<u>210-305</u>

Information upon completion of well:

(1) Diameter 4 inches.

(2) Total Depth 305 feet.

(3) Water Level 1 feet below top of ground.

(4) Cased to 161", Size 4"


(5) Screen: Size 0, Length _____

(6) Were any formations sealed against pollution?
✓ yes, _____ no.

If YES depth of formation _____

Why surface water

Drillers Remarks: _____

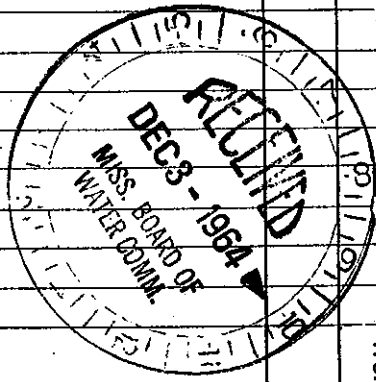

(Use Back Side)

Well No.

Mail this copy to Board of Water Commissioners 429 Miss. St. Jackson, Miss.