

LAUD.

MISSISSIPPI BOARD OF WATER COMMISSIONERS

B15

WATER WELL DRILLERS LOG

10-7-64

Date 10.7. 1964, Driller: McDonald & Hill, Inc County Lauderdale

(Name)

(1) Owner of Land: R.L. Richardson (Name) Rt. #1, Briley, Miss (Address)

(2) Location: 1/4, 1/4, Sec 21 8N 15E T R, 8 miles north of Mendon (distance) (direction) (Nearest Town)

(3) Topography: * (Hilly) (Flat) (Level)

(4) Purpose of Well: Domestic (Domestic Irrigation Municipal, Industrial, Other)

Description & Color of Materials Sand, Clay, Red Clay, Shell, etc.	Thick- ness Feet	Depth Feet
CLAY	0	35
SANDY SHALE	35	110
SHALE ST Lignite	110	224
SAND	224	245
SHALE	245	360
SAND ST SHALE	360	400

Information upon completion of well:

(1) Diameter 3 7/8 TEST HOLE inches.

(2) Total Depth 400' feet.

(3) Water Level 95' feet below top of ground.

(4) Cased to 250', Size 4"


(5) Screen: Size _____, Length _____.

(6) Were any formations sealed against pollution? _____yes, _____no.

If YES depth of formation _____.

Why _____.

Drillers Remarks: _____.

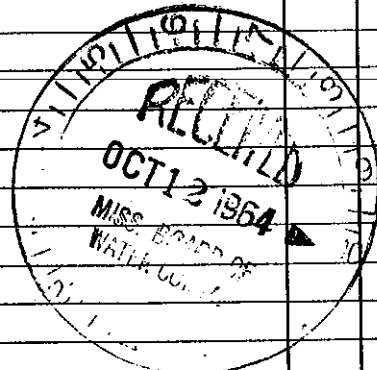

(Use Back Side)

Well No.

Mail this copy to Board of Water Commissioners 429 Miss. St. Jackson, Miss.