

BOARD OF WATER COMMISSIONERS

LAUD.


B17

WATER WELL DRILLERS LOG

Date: 7-28-64, 1964, Driller: M. E. Dowell & Hill, Inc. Landendale
County

(Name)

(1) Owner of Land: <u>GRADY McWILLIAMS</u> (Name)	Description & Color of Materials Sand, Clay, Red Clay, Shell, etc.	Thick- ness Feet	Depth Feet
<u>Rt # 2, Meridian, Miss</u> (Address)	<u>SAND CLAY</u>	<u>0</u>	<u>40</u>
(2) Location: <u>33</u> <u>E</u> <u>1/4</u> , <u>R</u> <u>33</u> <u>E</u> <u>1/4</u> Sec. <u>33</u> <u>E</u> <u>1/4</u> <u>R</u> (distance) (direction) (Nearest Town)	<u>SOFT SAND SHALE</u>	<u>40</u>	<u>110</u>
<u>8</u> miles <u>north</u> , of <u>Meridian</u> (distance) (direction) (Nearest Town)	<u>SHALE</u>	<u>110</u>	<u>190</u>
(3) Topography: <u>X</u> (Hilly) (Flat) (Level)	<u>SAND</u>	<u>190</u>	<u>225</u>
(4) Purpose of Well: <u>DOMESTIC</u> (Domestic Irrigation Municipal, Industrial, Other)			
Information upon completion of well:			
(1) Diameter: <u>3/8</u> <u>TEST HOLE</u> inches.			
(2) Total Depth: <u>225'</u> feet.			
(3) Water Level: <u>110'</u> feet below top of ground.			
(4) Cased to: <u>126'</u> , Size: <u>4"</u>			
(5) Screen: Size _____, Length _____			
(6) Were any formations sealed against pollution? <u>yes</u> , <u>no</u> .			
If YES depth of formation _____			
Why _____			
Drillers Remarks: _____			

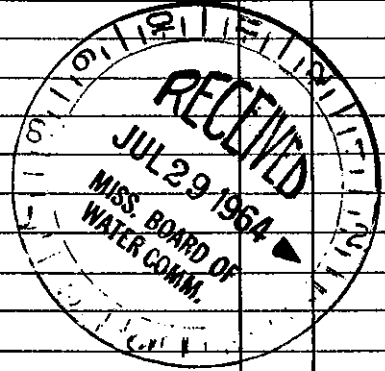

Well No.

(Use Back Side)

Retain this copy for your office files.