

LAUR

B 18

9-14-64

MISSISSIPPI BOARD OF WATER COMMISSIONERS

WATER WELL DRILLERS LOG


Date: 9-14, 1964, Driller: Bob Williams County Lauderdale (Name)

(1) Owner of Land: Woodrow Covington (Name) Rt. 2, Meridian (Address) (2) Location: 1/4, 1/4, Sec. 20 8N 15E T R, 10 miles North of Meridian (direction) (Hilly) (Level) (4) Purpose of Well: Fish pond (Domestic Irrigation, Municipal, Industrial, Other)

Table with 4 columns: Description & Color of Materials, Thickness Feet, Depth Feet. Rows include Blue Clay (10 ft, 1-10), White sand (40 ft, 10-50), Blue Clay (10 ft, 50-60), White sand (152 ft, 60-212).

Information upon completion of well:

(1) Diameter 6 inches. (2) Total Depth 212 feet. (3) Water Level 12 feet below top of ground. (4) Cased to 57, Size 6" (5) Screen: Size 0, Length (6) Were any formations sealed against pollution? yes, 0 no. If YES depth of formation Why Drillers Remarks:

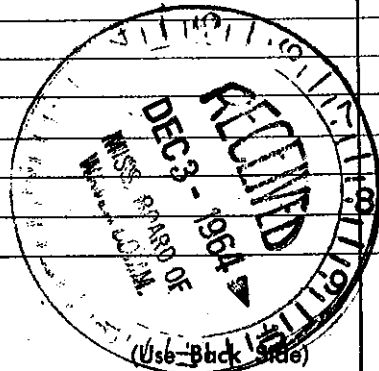

Well No.

Mail this copy to Board of Water Commissioners 429 Miss. St. Jackson, Miss.