

LAUD.
 B19
 4-10-65

MISSISSIPPI BOARD OF WATER COMMISSIONERS

WATER WELL DRILLERS LOG

Date: 4-10, 1965, Driller: Bob Williams County Laud.
 (Name)


(1) Owner of Land: James Wilson
 (Name)
Bailey, Miss.
 (Address)
 (2) Location: 1/4, 1/4, Sec. 2 8N 15E
 (distance) (direction) (Nearest Town)
12 miles North of Maudia
 (3) Topography: hilly
 (Hilly) (Flat) (Level)
 (4) Purpose of Well: domestic
 (Domestic Irrigation
 Municipal, Industrial, Other)

Description & Color of Materials Sand, Clay, Red Clay, Shell, etc.	Thick- ness Feet	Depth Feet
<u>Blue clay</u>	<u>43</u>	<u>1-43</u>
<u>Rock</u>	<u>2</u>	<u>43-45</u>
<u>Blue clay</u>	<u>165</u>	<u>45-210</u>
<u>gray sand</u>	<u>30</u>	<u>210-240</u>

Information upon completion of well:

(1) Diameter 4 inches.
 (2) Total Depth 240 feet.
 (3) Water Level 113 feet below top of ground.
 (4) Cased to 113, Size 4"
 (5) Screen: Size 0, Length _____
 (6) Were any formations sealed against pollution?
 yes, no.

If YES depth of formation _____
 Why surface water
 Drillers Remarks: _____

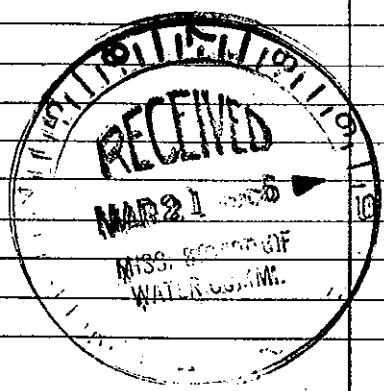

(Use Back Side)

tain this copy for your office files.

W.C.N.O.