

LAUDERDALE
B20
8-67

MISSISSIPPI
BOARD OF WATER COMMISSIONERS
416 North State Street
Jackson, Mississippi 39201

WATER WELL DRILLERS LOG

8-17-1967 date well completed
Jerry Dilling firm name
Laud county well located

LANDOWNER:
Wesley White
Bailey, Miss.
(mailing address)

WELL LOCATION:
sec. 14 T 8 N R 15 E
S W
10 miles N of Mdn.
(distance) (direction) (nearest town)

description of formations encountered	from	to
Yellow Clay	0	35
Blue Clay	35	90
sandy	90	150
hard clay & lignite	150	300
sand streaks	300	410

WELL PURPOSE:
(home, irrigation, municipal, industrial)

WELL COMPLETION DATA:

(1) diameter (inches) 4"

(2) total depth (feet) 410'

(3) static water level (feet) 200' below above top of ground.

(4) casing 3" 274'
(material) (depth)

(size) if telescope see back.

(5) screen No
(length) (depth to top)


(size) (material)

(6) pump 1/2 6
(HP) (yield gpm)
Submerg
(type power)

(7) electric log No
(yes or no)

(organization running log)

(8) how well bottom plugged open
Well

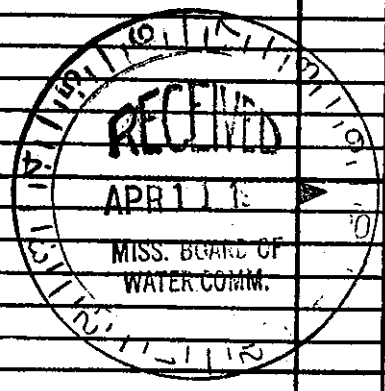

DRILLERS REMARKS: