

LAUDERDALE
B21
10-67

MISSISSIPPI
BOARD OF WATER COMMISSIONERS
416 North State Street
Jackson, Mississippi 39201

WATER WELL DRILLERS LOG

10-18-1967 *Jerry Drilling* *Laud*
date well completed firm name county well located

LANDOWNER:
Mr. Lyle Riddle
Rt 4, Meridian
(mailing address)

description of formations encountered	from	to
<i>Yellow sand</i>	<i>0</i>	<i>60</i>
<i>Blue sandy shale</i>	<i>60</i>	<i>90</i>
<i>Hard shale</i>	<i>90</i>	<i>100</i>
<i>Coarse sand</i>	<i>100</i>	<i>116</i>

WELL LOCATION:
sec. *19* T. *8* N R. *17* E
S W
13 miles *N* of *Meridian*
(distance) (direction) (nearest town)

WELL PURPOSE: *Home*
(home, irrigation, municipal, industrial)

WELL COMPLETION DATA:

(1) diameter (inches) *2"*

(2) total depth (feet) *116'*

(3) static water level (feet) *40* ^(below) above top of ground.

(4) casing *galv.* *110'*
(material) (depth)
If telescope see back.
(size)


(5) screen *6'* *110'*
(length) (depth to top)
2" *Stainless Steel*
(size) (material)

(6) pump *1* *8*
(HP) (yield gpm)
Jet
(type power)

(7) electric log *No*
(yes or no)

(organization running log)

(8) how well bottom plugged *wash*
Sub

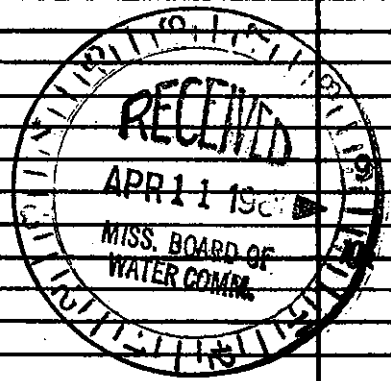

DRILLERS REMARKS: