

Rail
B22 CODED
6-65

MISSISSIPPI BOARD OF WATER COMMISSIONERS

WATER WELL DRILLERS LOG

6-11, 1965, Driller: Bob Williamson County Lauderdale
(Name)


Owner of Land: G. V. Wilson
(Name)
Railway, Miss.
(Address)
Location: SW 1/4, SW 1/4, Sec. 24 T. 8. R. 15
15 miles North of Medina
(distance) (direction) (nearest Town)
Topography: Hilly
(Hilly) (Flat) (Level)
Purpose of Well: domestic
(Domestic Irrigation, Municipal, Industrial, Other)

Description & Color of Materials Sand, Clay, Red Clay, Shell, etc.	Thick- ness Feet	Depth Feet
Red sand	25	1-25
6" rock		
Red sand	15	25-40
Blue & white clay	20	40-60
Mixed gray sand & Blue clay	65	60-125
gray sand	75	125-200
coal	10	200-210
Blue clay	20	210-230
gray sand	5	230-235
Blue clay	40	235-275
Mixed sand & clay	10	275-285
coal	5	285-290
Blue Clay	5	290-295
gray sand	220	295-515
stopped on Blue clay		

Information upon completion of well:
Diameter 4 inches.
Total Depth 317 feet.
Water Level 7 feet below top of ground.
Cased to 250, Size 4"
Screen: Size 0, Length _____
Were any formations sealed against pollution?
✓ yes, ✓ no.
ES depth of formation _____
surface water
Drillers Remarks: _____

CODED

[Handwritten scribbles]

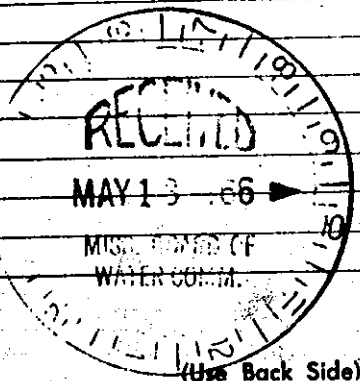

Well No