

WATER WELL DRILLERS LOG

Date: 6-1, 1966. Driller: Bob Williams County Tand
(Name)

(1) Owner of Land: <u>W. J. Scott</u> <small>(Name)</small>	Description & Color of Materials Sand, Clay, Red Clay, Shell, etc.	Thick- ness Feet	Depth Feet
<u>Bailey, Miss.</u> <small>(Address)</small>	<u>Red sand</u>	<u>30</u>	<u>1-30</u>
(2) Location: <u>NE 1/4, NE 1/4, Sec 26 T15N R15E</u>	<u>Blue clay</u>	<u>225</u>	<u>30-21</u>
<u>15 miles North of Jordan</u> <small>(Direction) (Nearest Town)</small>	<u>fine gray sand</u>	<u>41</u>	<u>255-2</u>
(3) Topography: <u>hilly</u> <small>(Hilly) (Flat) (Level)</small>			
(4) Purpose of Well: <u>domestic</u> <small>(Domestic Irrigation Municipal, Industrial, Other)</small>			


Information upon completion of well:

- (1) Diameter 2 inches.
- (2) Total Depth ~~296~~ 296 feet.
- (3) Water Level 188 feet below top of ground.
- (4) Cased to 226, Size 2"
- (5) Screen Size 0 Length
- (6) Were any formations sealed against pollution?
 yes, no.

If YES depth of formation
 Why surface water

Drillers Remarks:

CODED

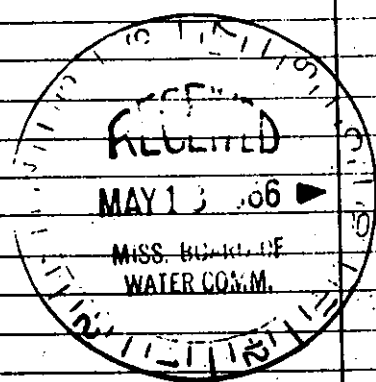

(Use Back Side)

Well No.

stain this copy for your office files.