

3 13 P

32 32 30 N 0 88 43 25

TETU

Lauderdale
B24
7-22-68

MISSISSIPPI
BOARD OF WATER COMMISSIONERS
416 North State Street
Jackson, Mississippi 39201

CODE 1

WATER WELL DRILLERS LOG

July 22 1968 Williamson Drilling Co. Lauderdale
date well completed firm name county well located


LANDOWNER James F White
Ot Bailey Linn.
(mailing address)
WELL LOCATION:
sec. 13 T. 8 N R. 15 E
9 miles North of Prentiss
(distance) (direction) (nearest town)

description of formations encountered	from	to
Red Clay	0	3
Blue Clay	3	90
riped sand + Clay	90	220
Blue Clay	220	290
fine gray sand	290	360

WELL PURPOSE: Home
(home, irrigation, municipal, industrial)

- WELL COMPLETION DATA:
- (1) diameter (inches) 4
 - (2) total depth (feet) 360
 - (3) static water level (feet) 160 ^{below}/_{above} top of ground.
 - (4) casing Block 231 (material) (depth)
4 (size) if telescope see back.
 - (5) screen No (length) (depth to top)
(size) (material)
 - (6) pump 1 (HP) 18 (yield gpm)
Ebot (type power)
 - (7) electric log No (yes or no)
No (organization running log)
 - (8) how well bottom plugged Open

CODE 1

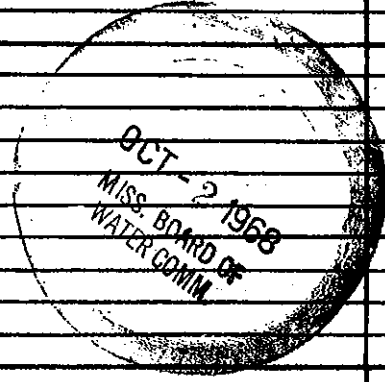

DRILLERS REMARKS: