

B 33
9-14-62

WATER WELL DRILLERS LOG **CODED**

Date: 9-14, 1962, Driller: McDonald - Hill County Landstate
(Name)

(1) Owner of Land: W.S. (Bie) Russell
(Name)
Rt 1 Bailey
(Address)

(2) Location: 23 8 15
T R
_____ miles _____ of _____
(distance) (direction) (Nearest Town)

(3) Topography: (Hilly) (Flat) (Level)

(4) Purpose of Well: Domestic
(Domestic Irrigation, Municipal, Industrial, Other)

Description & Color of Materials Sand, Clay, Red Clay, Shell, etc.	Thick- ness Feet	Depth Feet
<u>Clay</u>	<u>0</u>	<u>18</u>
<u>B shale</u>	<u>18</u>	<u>198</u>
<u>Sandy shale</u>	<u>198</u>	<u>232</u>
<u>Shale</u>	<u>232</u>	<u>260</u>
<u>fine sand</u>	<u>260</u>	<u>335</u>

Information upon completion of well:

(1) Diameter 3 inches.

(2) Total Depth 335' feet.


(3) Water Level 130 feet below top of ground.

(4) Cased to 168, Size 3

(5) Screen: Size , Length

(6) Were any formations sealed against pollution?
 yes, no.

CODED

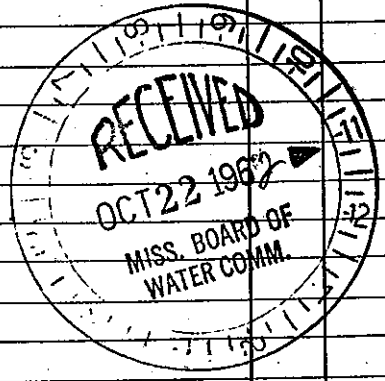

If YES depth of formation _____

Why _____

Drillers Remarks: _____

Well No.

(Use Back Side)