

WATER WELL DRILLERS LOG

CODED

LAUD
B 35
4-10-63

Date: 4-10-63, 1963, Driller: M. McDonald & Hill County: Madison
(Name)


(1) Owner of Land: JAKE SMITH
(Name)
R#2 MERIDIAN
(Address)
(2) Location: 1/4, 27 Sec. S 15
10 miles N WEST of MERIDIAN
(distance) (direction) (Nearest Town)
(3) Topography: X
(Hilly) (Flat) (Level)
(4) Purpose of Well: DOMESTIC
(Domestic Irrigation, Municipal, Industrial, Other)

Description & Color of Materials Sand, Clay, Red Clay, Shell, etc.	Thick- ness Feet	Depth Feet
<u>CLAY</u>	<u>0</u>	<u>10</u>
<u>SANDY CLAY</u>	<u>10</u>	<u>30</u>
<u>CLAY</u>	<u>30</u>	<u>70</u>
<u>BLUE CLAY</u>	<u>70</u>	<u>142</u>
<u>ROCK</u>	<u>142</u>	<u>148</u>
<u>SANDY</u>	<u>148</u>	<u>200</u>
<u>SHALE</u>	<u>200</u>	<u>290</u>
<u>ROCK</u>	<u>290</u>	<u>293</u>
<u>SAND</u>	<u>293</u>	<u>320</u>

Information upon completion of well:

(1) Diameter 4" inches.
(2) Total Depth 320' feet.
(3) Water Level 110' feet below top of ground.
(4) Cased to 2/2, Size 4"
(5) Screen: Size _____, Length _____
(6) Were any formations sealed against pollution?
_____ yes, X no.
If YES depth of formation _____
Why _____
Drillers Remarks: _____

CODED

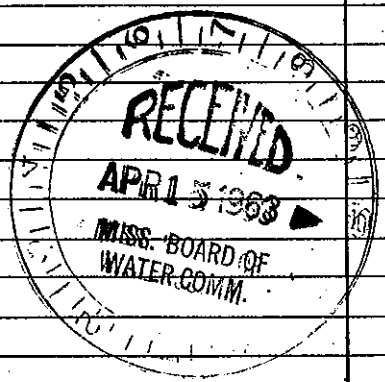

Well No.

(Use Back Side)

Mail this copy to Board of Water Commissioners 429 Miss. St. Jackson, Miss