

MISSISSIPPI BOARD OF WATER COMMISSIONERS

L.A.U.D.
B 36
7-29-63

WATER WELL DRILLERS LOG

CODED

Date: 7-29, 1963, Driller McDonald & Hill County Lauderdale
(Name)


(1) Owner of Land Bill Spincy
(Name)
(Address) 35815
(2) Location: 1/4, 1/4, Sec. T R
11 miles N.W., of Meridian
(distance) (direction) (Nearest Town)
(3) Topography: Hilly
(Hilly) (Flat) (Level)
(4) Purpose of Well: Domestic
(Domestic Irrigation, Municipal, Industrial, Other)

Description & Color of Materials Sand, Clay, Red Clay, Shell, etc.	Thick- ness Feet	Depth Feet
<u>Clay</u>	<u>0</u>	<u>18</u>
<u>Sand</u>	<u>18</u>	<u>20</u>
<u>Shale w/ lign. str.</u>	<u>20</u>	<u>60</u>
<u>Shale</u>	<u>60</u>	<u>102</u>
<u>Silty shale</u>	<u>102</u>	<u>115</u>
<u>Shale w/ lign. str.</u>	<u>115</u>	<u>195</u>
<u>Silty shale & sd</u>	<u>195</u>	<u>225</u>
<u>Shale (Coarse)</u>	<u>225</u>	<u>262</u>

Information upon completion of well:

(1) Diameter 3 7/8 inches.
(2) Total Depth 262 feet.
(3) Water Level 66 feet below top of ground.
(4) Cased to 145, Size 4"
(5) Screen: Size _____, Length _____
(6) Were any formations sealed against pollution?
_____ yes, _____ no.
If YES depth of formation _____
Why _____
Drillers Remarks: _____

CODED

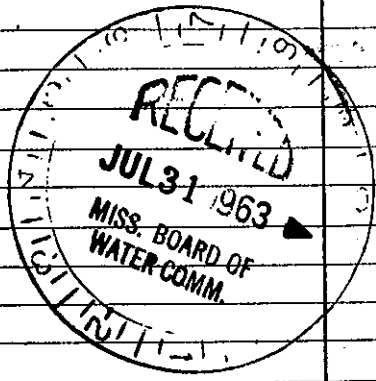

(Use Back Side)

Well No.

Mail this copy to Board of Water Commissioners 429 Miss. St. Jackson, Miss.