

B37
10-28-63

WATER WELL DRILLERS LOG

CODED


Date: 10-28, 1963, Driller: Mr. Donald A. Hill County Jackson
(Name)

(1) Owner of Land:	Description & Color of Materials Sand, Clay, Red Clay, Shell, etc.	Thick- ness Feet	Depth Feet
A.P. Miller (Name)	Clay	0	87
RT #2, Meridian, Miss. (Address)	shale	37	90
(2) Location: 1/4, 2, Sec. 8, R. 15	shale w/ lign. st.	90	200
12 miles N, of Meridian (distance) (direction) (Nearest Town)	Hard sdy. shale	200	220
(3) Topography: Hilly	shale	220	245
(4) Purpose of Well: Domestic	Hard sdy. shale	245	260
(Domestic Irrigation Municipal, Industrial, Other)	shale	260	290
	sdy. shale	295	304
	fine sd.	304	310
	Coarse sand	310	322

Information upon completion of well:

- (1) Diameter 3 7/8 inches.
- (2) Total Depth 320 feet.
- (3) Water Level 160 feet below top of ground.
- (4) Cased to 319, Size 4x2
- (5) Screen: Size 2", Length 6'
- (6) Were any formations sealed against pollution?
_____ yes, _____ no.

CODED

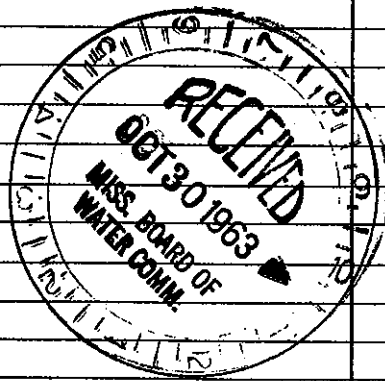

If YES depth of formation _____

Why _____

Drillers Remarks: _____

Well No.
124

(Use Back Side)