

MISSISSIPPI BOARD OF WATER COMMISSIONERS

LAUD.  
B39  
11-5-64

WATER WELL DRILLERS LOG

**CODED**

Date: 11-5, 1964, Driller: M. E. Donald & Hill, Inc. Landersdale  
County

(Name)

(1) Owner of Land: GEROLD PACE  
(Name)  
Rt #2, Mendisway Miss  
(Address)

Description & Color of Materials  
Sand, Clay, Red Clay, Shell, etc.

Thick-  
ness  
Feet

Depth  
Feet

CLAY          0    20  
SHALE         20   230  
SANDY SHALE   230 250

(2) Location: 1/4, 1/4, Sec. 17 & 15  
\_\_\_\_\_ miles \_\_\_\_\_ of \_\_\_\_\_  
(distance)      (direction)      (Nearest Town)

(3) Topography: X  
(Hilly)      (Flat)      (Level)

(4) Purpose of Well: DOMESTIC  
(Domestic Irrigation  
Municipal, Industrial, Other)

**CODED**

Information upon completion of well:

(1) Diameter: 3/4 TEST HOLE inches.

(2) Total Depth: 250' feet.

(3) Water Level: 132' feet below top of ground.

(4) Cased to 147', Size 2" GALV

(5) Screen: Size \_\_\_\_\_, Length \_\_\_\_\_


(6) Were any formations sealed against pollution?

\_\_\_\_\_ yes, \_\_\_\_\_ no.

If YES depth of formation \_\_\_\_\_

Why \_\_\_\_\_

Drillers Remarks: \_\_\_\_\_

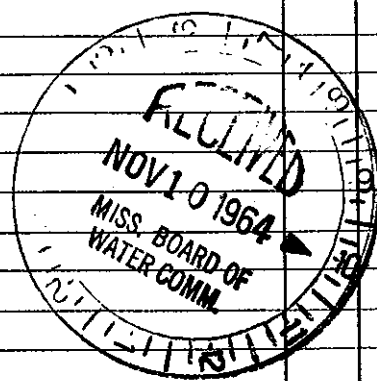

Well No.

(Use Back Side)

Mail this copy to Board of Water Commissioners 429 Miss. St. Jackson, Mis.