

MISSISSIPPI BOARD OF WATER COMMISSIONERS

WATER WELL DRILLERS LOG

**CODED**

L.A.V.D.  
B40  
6-11-65

Date: 6-11, 1965, Driller: Bob Williamson County David  
(Name)

(1) Owner of Land: G.V. Wilson  
(Name)  
Bailey, Miss.  
(Address)

(2) Location: 1/4, 2 1/4, Sec. 8 15  
15 miles North of Mudica  
(distance) (direction) (Nearest Town)

(3) Topography: Hilly  
(Hilly) (Flat) (Level)

(4) Purpose of Well: domestic  
(Domestic Irrigation  
Municipal, Industrial, Other)

Description & Color of Materials Sand, Clay, Red Clay, Shell, etc.	Thick- ness Feet	Depth Feet
Red sand	25	1-25
6" neck		
Red sand	15	25-40
Blue & white clay	20	40-60
Mixed gray sand & Blue clay	6.5	60-125
gray sand	7.5	125-200
coal	10	200-310
Blue clay	20	210-230
gray sand	5	230-235
Blk. clay	40	235-275
Mixed sand & clay	10	275-285
coal	5	285-290
Blue Clay	5	290-295
gray sand	2.2	295-317
Stopped on Blue clay		

Information upon completion of well:

(1) Diameter 4 inches.

(2) Total Depth 317 feet.

(3) Water Level ? feet below top of ground.

(4) Cased to 250, Size 4"

(5) Screen: Size 0, Length \_\_\_\_\_


(6) Were any formations sealed against pollution?  
✓ yes, ✓ no.

If YES depth of formation \_\_\_\_\_

Why surface water

Drillers Remarks: \_\_\_\_\_

**CODED**

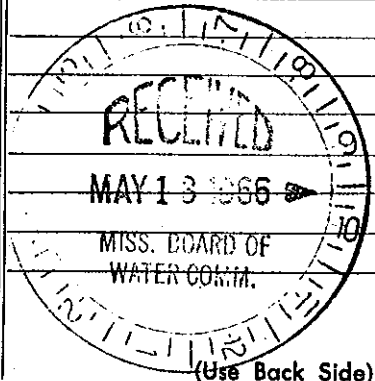

Well No.

tain this copy for your office files.