State Well Report				
1	Part 1	For Office Use Only:		
Mississippi Departme	ent of Environmental Quality	Aquifer:		
	and Water Resources	Aquier: Well #: <u>B-69</u>		
Diffier:	P.O. Box 10631 Jackson, MS 39289-0631			
	1)961-5210	L. S. Elevation:		
(601)3	54-6938 (fax)	E-log #:		
State Law requires that this report be prepared by the driller in detail and filed with the Department within 30 days of completion of drilling of the well.				
Well Owner Information	Wel	1 Location		
Owner Name David Jones	Latitude: <u>32 • 33 · 244</u>	2" Longitude: <u>55° 46, 32</u> 3		
Mailing Address: 10675 ftwy 495		Method of Lat/Long (circle one): Conventional Survey, 77		
	-	USGS quad, Hand-held GPS, Survey-grade GPS		
Meridian miss 39305 City State Zip Code	SE 4 NW 4 Sec 9	SE 14 NW 14 Sec 9 Twn T SIV Rng 12-E		
Telephone No. (601) 437 - 2349	Distance Direction Nearest Town			
We	ll Data			
Purpose of Well (circle one) Home Industrial Public Supply Irrigation Fish Culture Other:				
Date well drilling started: $2 - 18 - 08$ Date well drilling completed: $2 - 25 - 08$				
If flowing, method of flow regulation: Valve Other (describe)				
Static Water Level: 135 feet above or below (circle one) land surface Date measured: $2-25-95$				
Method of Measurement (circle one) steel tape electric ta	pe air line other:			
Hole depth: 315 Well depth: 315 Well grouted to a depth of 12 RECENT				
Type of grout (circle one): (Cement) Bentonite M	ix	-OLIVED		
Type of grout (circle one): Cement Bentonite Mix Casing length: 210 feet Casing diameter: 4 inches Type of casing: PVC MAR n 5 2008 Screen length:				
Screen length:feet Screen diameter:inches Type of screen:/				
Screen slot size:inches Setting depth: Fromfeet tofeet				
Type of completion (circle all applicable): Gravel packed Underreamed Telescoped Open hole Natural Development				
Other (describe):				
Top of lap pipe or reduction in casing:feet. If	Top of lap pipe or reduction in casing:feet. If telescoped or more than one screen, describe on back of page			
Logs run (circle all applicable): No log run Electric Gamma Ray Density Sonic Neutron Other:				
Name of organization running log(s): I certify that the well was drilled, constructed, and completed in accordance with all applicable requirements of the Mississippi				
Department of Environmental Quality and/or the Mississippi Department of Health regulations and state laws.				
Tim Smith	Tum	Smith		
Print Name of Water Well Contractor and License No.	· · · · · · · · · · · · · · · · · · ·	f Water Wall Contractor		

Print Name of Water Well Contractor and License No.

*

.

Signature of Water Well Contractor

If well telescopes please sketch below and show depths.


Ground Level

¥

Description of Formations Encountered	From	To
BINE Clay Bine Clay Sand & Clay	0 18 85 210	18 85 210 315

B-69

If more than one screen, show location of each on sketch

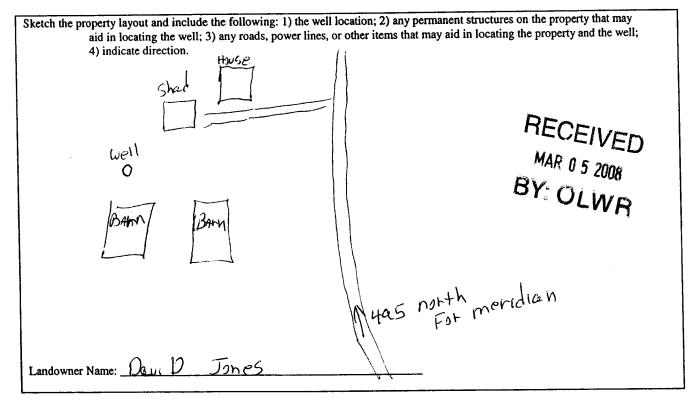

Signature of Water Well Contractor

STATE WE	ELL REPORT			
County: $LauredalePermit #:Pump Installer'sPermit #:Mississippi DepartmenDriller:Tim SmithDate completed:2-25-28(601)(601)35$	For Office Use Only:art 2For Office Use Only:act of Environmental Quality and Water ResourcesAquifer: $30x 10631$ $15 39289-0631$ $961-5210$ $4-6938 (fax)$ Well #: $B - 69$ Elevation:and filed with the Department within 30 days of the			
This report should be prepared by the pump installer in detail and filed with the Department within 30 days of the installation of pump.				
Well Owner Information Owner Name: Devid Jones	Well Location Latitude: 32° 33° 245 Longitude: 58° 46° 323			
Mailing Address: 10675 Harry 495	Method of Lat/Long (circle one): Conventional Survey,			
	USGS quad, Hand-held GPS, Survey-grade GPS			
Mondan M155 39.305 City State Zip Code Telephone No. (601) 739-2349	$\frac{14}{14} \frac{14}{\text{Sec}} \frac{9}{\text{Twn}} \frac{1}{\text{TSN}} \frac{15}{\text{Rng}R} - 15}{\frac{15}{15}} = E$ Distance Direction Nearest Town			
Telephone No. $(\underline{0}^{-1})$ 13 $(\underline{2}, \underline{7})$	20 Miles N of Metidian			
Pump Type Circle one	Power Type Circle one			
Air Lift Jet Submersible	Diesel Engine Gasoline Engine Natural Gas			
Bucket Piston Turbine	Electric Motor Hand Tractor PTO			
Centrifugal Rotary Flowing Well	Windmill Other (specify):			
Other (specify):	Horse Power Rating of Motor: RECEIVED			
Date Pump Installed: <u>2-25 - 08</u>	Setting Depth: So MAR feet 5 2000			
Rated Pump Capacity: Gallons Per Minute	Number of Stages: 14 BY: OLWP			
Pump Test Data	Method of Measuring Water Level Circle one			
Date Well Tested: <u>2 - 25 - 08</u>				
Static Water Level (A): <u>135</u> Feet Below Land Surface	Air Line Electric Measuring Line Steel Tape Other (specify):			
Pumping Water Level (B): <u>160</u> Feet Below Land Surface				
Drawdown [(B) – (A)]:Feet Below Land Surface	For flowing well, measured shut in head:feet			
Test Pumping Rate:Gallons Per Minute	Well yielded GPM with a drawdown of			
Duration of Pump Test (minimum 4 hours):hours	<u>25</u> feet after <u>6</u> hours of pumping			
I HEREBY CERTIFY that the above statements are true to the best of my knowledge. <u>TIM Shith</u> Print Name of Pump Installer and License No. (if applicable) Signature of Pump Installer				