


LAUDERDALE
B 9022
3-5-81
3-5-81

MISSISSIPPI
 BOARD OF WATER COMMISSIONER
 416 North State Street
 Jackson, Mississippi 39201

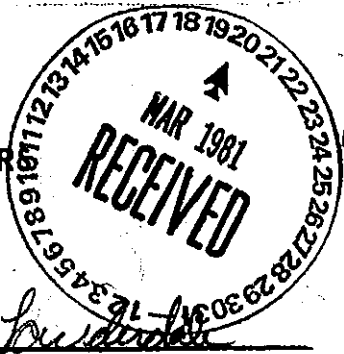

WATER WELL DRILLERS LOG

19 Mc Donald & Hill Lauderdale
 firm name county well located

LANDOWNER:

Bonnie Jane Daniels
Rt # 2 Box 233, Meridian
 (mailing address)

description of formations encountered

from to

<u>clay & sand</u>	<u>0</u>	<u>25</u>
<u>shale</u>	<u>25</u>	<u>40</u>
<u>fine sandy shale</u>	<u>40</u>	<u>80</u>
<u>shale & lignite</u>	<u>80</u>	<u>105</u>
<u>shale & fine sand</u>	<u>105</u>	<u>130</u>
<u>lignite & shale</u>	<u>130</u>	<u>225</u>
<u>sandy shale & fine sand</u>	<u>225</u>	<u>320</u>

WELL LOCATION:

sec. 9 T. 8 N. R. 15 E
1 miles NW of Shrickton
 (distance) (direction) (nearest town)


WELL PURPOSE: home
 (home, irrigation, municipal, industrial)

WELL COMPLETION DATA:

- (1) diameter (inches) 4"
- (2) total depth (feet) 320'
- (3) static water level (feet) 110' ^{below}/_{above} top of ground.
- (4) casing PVC, 180'
 (material) (depth)
4"
 (size) If telescope see back.
- (5) screen _____
 (length) (depth to top)
 (size) (material)
- (6) pump 1/2 600m
 (HP) (yield/gpm)
E
 (type power)
- (7) electric log _____
 (yes or no)
 (organization running log)
- (8) how well bottom plugged open

DEPT. OF NATURAL RESOURCES
 BUREAU OF LAND & WATER RESOURCES

MAR 20 1981

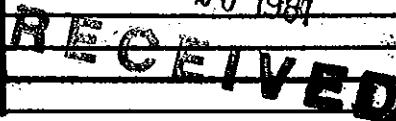

DRILLERS REMARKS: