


L.A.U.D.
C9
4-62

MISSISSIPPI BOARD OF WATER COMMISSIONERS

WATER WELL DRILLERS LOG

Date: April, 1962, Driller: Peeples + Rutledge County Lauderdale
(Name)

(1) Owner of Land: <u>Mrs. Fred Brasch</u> (Name)	Description & Color of Materials Sand, Clay, Red Clay, Shell, etc.	Thick- ness Feet	Depth Feet
(Address)	<u>Yellow sand + sandy</u>		
(2) Location: <u>NE 1/4, SE 1/4, Sec. 29 T8R16,</u> <u>Hickory 39</u>	<u>clay streaks</u>	<u>63</u>	<u>63</u>
<u>10</u> miles <u>N</u> , of <u>Meridian</u> , (distance) (direction) (Nearest Town)	<u>Blue marl</u>	<u>17</u>	<u>80</u>
(3) Topography: <u>Hilly</u> (Hilly) (Flat) (Level)	<u>Yellow sand</u>	<u>15</u>	<u>95</u>
(4) Purpose of Well: <u>Domestic</u> (Domestic Irrigation Municipal, Industrial, Other)	<u>Yellow sand + yellow</u> <u>clay streaks</u>	<u>30</u>	<u>125</u>
	<u>Gray sand + sandy</u> <u>shale streaks</u>	<u>17</u>	<u>142</u>
	<u>Rock</u>	<u>1</u>	<u>143</u>
Information upon completion of well:	<u>gray sand + sandy</u> <u>shale streaks</u>	<u>25</u>	<u>168</u>
(1) Diameter <u>2</u> inches.	<u>soft gray sandy shale</u> <u>+ small sand streaks</u>	<u>144</u>	<u>334</u>
(2) Total Depth <u>378</u> feet.	<u>Rock</u>	<u>2</u>	<u>336</u>
(3) Water Level <u>148</u> feet below top of ground.	<u>Gray + white mixed sand</u>	<u>42</u>	<u>378</u>
(4) Cased to <u>372</u> , Size <u>2"</u>			
(5) Screen: Size <u>2"</u> , Length <u>6'</u>			
(6) Were any formations sealed against pollution? <u>yes</u> , <u>no</u> .			
If YES depth of formation _____			
Why _____			
Drillers Remarks: <u>high yield</u>			

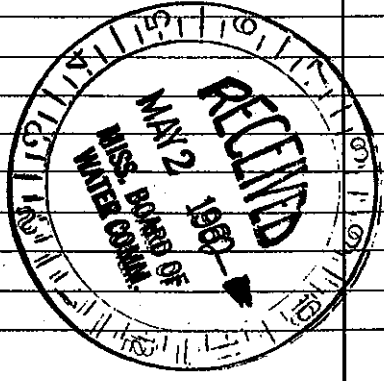

(Use Back Side)

Well No. _____

Mail this copy to Board of Water Commissioners 429 Miss. St. Jackson.