

LAUD.

C 10

3-21-66

WATER WELL DRILLERS LOG

Date: 3-27, 1966, Driller: McDonald & Hill Inc County Lauderdale

(Name)

(1) Owner of Land:	Description & Color of Materials Sand, Clay, Red Clay, Shell, etc.	Thick- ness Feet	Depth Feet
Name: <u>WILLIE LEE BROWN</u>	<u>CLAY</u>	<u>0</u>	<u>14</u>
Address: <u>R#1 BAILEY MISS</u>	<u>YELLOW CLAY</u>	<u>14</u>	<u>26</u>
Location: <u>32 8N 16E</u>	<u>SOFT SHALE</u>	<u>26</u>	<u>45</u>
ON <u>BAILEY & LIZELA ROAD</u>	<u>SHALE</u>	<u>45</u>	<u>90</u>
<u>5</u> miles <u>NE</u> , of <u>BAILEY</u>	<u>SAND</u>	<u>90</u>	<u>114</u>
(distance) (direction) (Nearest Town)	<u>SHALE ST LIGNITE</u>	<u>114</u>	<u>230</u>
(2) Topography: <u>X</u>	<u>SANDY SHALE</u>	<u>230</u>	<u>260</u>
(Hilly) (Flat) (Level)	<u>SHALE</u>	<u>260</u>	<u>290</u>
(4) Purpose of Well: <u>Domestic</u>	<u>SAND</u>	<u>290</u>	<u>320</u>
(Domestic, Irrigation, Municipal, Industrial, Other)			


Information upon completion of well:

- (1) Diameter: 3 1/4 inches. TEST HOLE
- (2) Total Depth: 320' feet.
- (3) Water Level: 170' feet below top of ground.
- (4) Cased to: 210', Size 2"
- (5) Screen: Size _____, Length _____
- (6) Were any formations sealed against pollution?
_____ yes, X no.

If YES depth of formation _____

Why _____

Drillers Remarks: _____

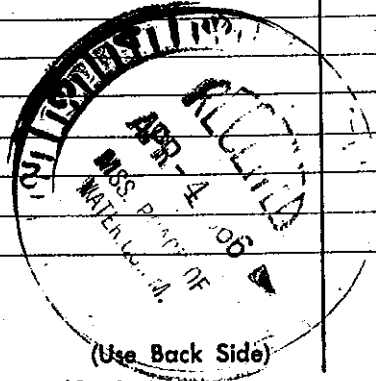

Well No.

Mail this copy to Board of Water Commissioners 429 Miss. St. Jackson, Miss.