

Lauderdale
C12
5-67

MISSISSIPPI
BOARD OF WATER COMMISSIONERS
416 North State Street
Jackson, Mississippi 39201

WATER WELL DRILLERS LOG

5.24.67 19 McDonald Hill LAUDERDALE
date well completed firm name county well located

LANDOWNER: CLIFF WALKER

R#4 MERIDIAN

(mailing address)

WELL LOCATION:

sec. 28 T. 8 N R. 6 E
S W
9 miles NORTH of MERIDIAN
(distance) (direction) (nearest town)

description of formations encountered


from to

CLAY	0	10
MELLOW Clay Sand	10	50
SAND ST. SHALE	50	144
SHALE	144	170
SAND ST. SHALE	170	200
FINE SAND	200	290
SAND	290	302
SHALE	302	340
SAND	340	362

WELL PURPOSE: HOME
(home, irrigation, municipal, industrial)

WELL COMPLETION DATA:

- diameter (inches) 4" WELL
- total depth (feet) 362
- static water level (feet) 65' below top of ground.
- casing BLACK, 173' (material) (depth)
4" (size) If telescope see back.
- screen 6' 356' (length) (depth to top)
2" STEEL (size) (material)
- pump 1HP 20 (HP) (yield gpm)
230 (type power)
- electric log NO (yes or no)
NO (organization running log)
- how well bottom plugged VALVE

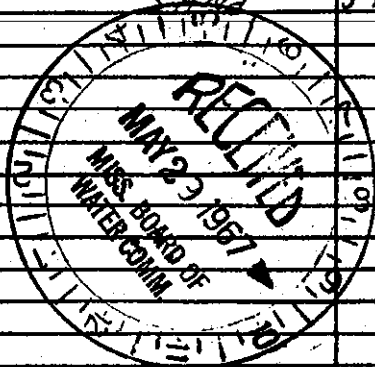

DRILLERS REMARKS: