

Lauderdale
 C14
 10-67

MISSISSIPPI
 BOARD OF WATER COMMISSIONERS
 416 North State Street
 Jackson, Mississippi 39201

WATER WELL DRILLERS LOG

10.10.67 date well completed
 McDONALD + HILL firm name
 LAUDERDALE county well located

LANDOWNER: ET NEWELL

description of formations encountered

from to

R# 4 MERIDIAN

Clay 0 10

Hwy 89 NORTH
 (mailing address)

Shale 10 37

WELL LOCATION:

sec. 21 T. 8 N R. 16 E
 S W

8 miles NORTH of MERIDIAN
 (distance) (direction) (nearest town)

Shale w/ lignite 37 80

WELL PURPOSE: HOME
 (home, irrigation, municipal, industrial)

Sandy 80 130

WELL COMPLETION DATA:

(1) diameter (inches) 2" WELL

(2) total depth (feet) 230'

(3) static water level (feet) 175' below top of ground.

(4) casing GALV 220'
 (material) (depth)

2" If telescope see back.
 (size)

(5) screen 5' 222
 (length) (depth to top)

2" BRASS
 (size) (material)

(6) pump 1/2 HP 5
 (HP) (yield gpm)

220
 (type power)

(7) electric log NO
 (yes or no)

NO
 (organization running log)

(8) how well bottom plugged VALVE

Soft to med shale 130 147


Sandy 147 180

Rock 180 187

Sandy 187 190

Sand 190 220

Sand 220 228

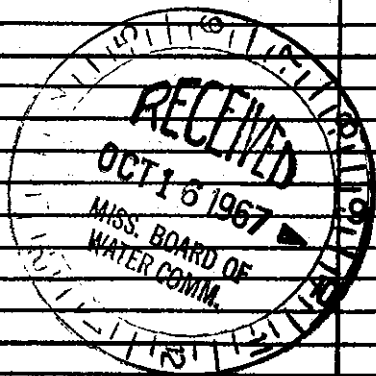

DRILLERS REMARKS: