

LAUD.

MISSISSIPPI BOARD OF WATER COMMISSIONERS

C15
5-10-63

WATER WELL DRILLERS LOG

Common Well Ser

Lauderdale

Date: 5-10, 1963, Driller: Ray Cox

County: Lauderdale

(Name)

(1) Owner of Land: <u>Phu Hons Bao</u> (Name)	Description & Color of Materials Sand, Clay, Red Clay, Shell, etc.	Thick- ness Feet	Depth Feet
<u>Meridian, Miss</u> (Address)	0-15' Red Clay & Chalk		
(2) Location: <u>30 2 N 2 E</u>	15-20' Sand		
<u>6</u> miles <u>N</u> of <u>Meridian</u> (distance) (direction) (Nearest Town)	20-68' Blue Chalk		
(3) Topography: <u>Hilly</u> (Hilly) (Flat) (Level)	68-71' Hard Rock		
(4) Purpose of Well: (Domestic Irrigation Municipal, Industrial, Other)	71-85' Brown Chalk		
Information upon completion of well:	85-100' Sand		

(1) Diameter 2" inches.

(2) Total Depth 100 feet.

(3) Water Level 30' feet below top of ground.

(4) Cased to 94', Size 2"


(5) Screen: Size 2", Length 6'

(6) Were any formations sealed against pollution?
 yes, no.

If YES depth of formation _____

Why _____

Drillers Remarks:
Common Water Well Drilling
Subtotal Price

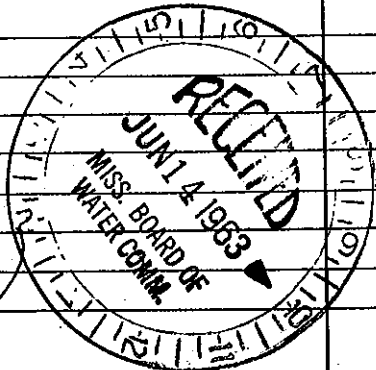

(Use Back Side)

Well No.