

C 16

10-9-63

WATER WELL DRILLERS LOG


Date: 10, 9, 1963, Driller: M^eDonald J Hill County Lauderdale
 (Name)

(1) Owner of Land: Glynn Miller
 (Name)
Rt #4
 (Address)
8N16E
 (2) Location: 1/4, 1/4, Sec. 4 T. R
10 miles North, of Mendenhall
 (distance) (direction) (Nearest Town)
 (3) Topography: V
 (Hilly) (Flat) (Level)
 (4) Purpose of Well: DOMESTIC
 (Domestic Irrigation
 Municipal, Industrial, Other)

Description & Color of Materials Sand, Clay, Red Clay, Shell, etc.	Thick- ness Feet	Depth Feet
CLAY	0	12
SHALE	12	28
CLAY	28	40
SHALE	40	95
Yellow Sand	95	180
SHALE	180	370
SAND	370	400

Information upon completion of well:

(1) Diameter 4" inches.
 (2) Total Depth 400' feet.
 (3) Water Level 165' feet below top of ground.
 (4) Cased to 215', Size 4"
 (5) Screen: Size _____, Length _____
 (6) Were any formations sealed against pollution?
 _____ yes, _____ no.
 If YES depth of formation _____
 Why _____
 Drillers Remarks: _____

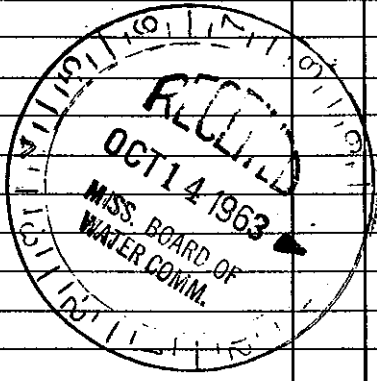

(Use Back Side)

Well No.