

LAUD.  
C 18  
12-27-65

MISSISSIPPI BOARD OF WATER CONTROL

WATER WELL DRILLERS LOG

Date: 12/27, 1965, Driller: TERRY County laud.  
(Name)

(1) Owner of Land: <u>SONNY CUNNINGHAM</u> (Name)	Description & Color of Materials Sand, Clay, Red Clay, Shell, etc.	Thick- ness Feet	Depth Feet
<u>Rt 4 MERIDIAN, MISS</u> (Address)	<u>YELLOW SAND &amp; CLAY</u>	<u>0</u>	<u>65</u>
(2) Location: <u>1/4, 1/4, Sec. 15 8N 16E</u> <u>9</u> miles <u>north</u> , of <u>MDN.</u> (distance) (direction) (Nearest Town)	<u>BLUE SAND &amp; MUD</u>	<u>65</u>	<u>195</u>
(3) Topography: <u>✓</u> (Hilly) (Flat) (Level)	<u>BLUE DIET</u>	<u>195</u>	<u>360</u>
(4) Purpose of Well: <u>DOMESTIC</u> (Domestic Irrigation Municipal, Industrial, Other)	<u>SANDY</u>	<u>360</u>	<u>420</u>

Information upon completion of well:

(1) Diameter 4 inches.

(2) Total Depth 420 feet.

(3) Water Level 180' feet below top of ground.

(4) Cased to 234, Size 4


(5) Screen: Size No, Length \_\_\_\_\_

(6) Were any formations sealed against pollution?  
\_\_\_\_\_ yes, \_\_\_\_\_ no.

If YES depth of formation \_\_\_\_\_

Why \_\_\_\_\_

Drillers Remarks: Good water -  
NO IRON

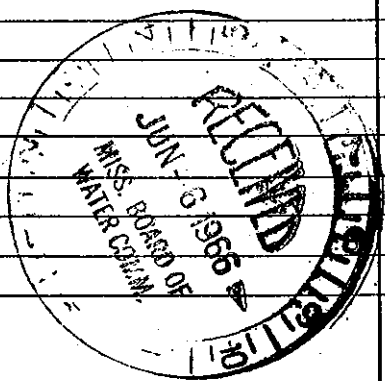

(Use Back Side)

Well No