

LAUD. MISSISSIPPI

C 19

2-24-66

WATER WELL DRILLERS LOG

Date: 2/24, 1966, Driller: TERRY County LAUD

	Description & Color of Materials Sand, Clay, Red Clay, Shell, etc.	Thick- ness Feet	Depth Feet
(1) Owner of Land: ED HARVEY (Name)	SAND + CLAY	0	78'
Pt 4 MERIDIAN (Address)	SHALE + SAND	78	165'
(2) Location: 1/4, 1/4, Sec. 4 8 N 16 E T. R.	BLUE dirt	165	240
10 miles NORTH, of MDN. (distance) (direction) (Nearest Town)	SHALE + SAND STREAK	240	406
(3) Topography: <input checked="" type="checkbox"/> (Hilly) <input type="checkbox"/> (Flat) <input type="checkbox"/> (Level)			
(4) Purpose of Well: DOMESTIC (Domestic Irrigation, Municipal, Industrial, Other)			

Information upon completion of well:

(1) Diameter 4 inches.

(2) Total Depth 406 feet.

(3) Water Level 144 feet below top of ground.

(4) Cased to 220, Size 4


(5) Screen: Size 1/6, Length _____

(6) Were any formations sealed against pollution?
_____ yes, _____ no.

If YES depth of formation _____

Why _____

Drillers Remarks: Good WATER

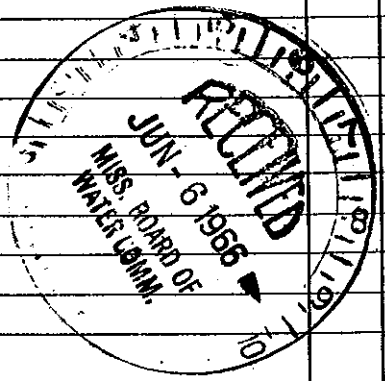

Wei