


LAUD.  
 # C 20  
 1-18-63

**WATER WELL DRILLERS LOG**

Date: 1-18, 1963, Driller: McDonald - Hill, Inc. County: Franklin  
 (Name)

(1) Owner of Land:	Description & Color of Materials Sand, Clay, Red Clay, Shell, etc.	Thick- ness Feet	Depth Feet
(Name) <u>Mrs. Betha Casaway</u> (Address) <u>Rt. 4 Meadison</u>	Sand	0	0
(2) Location: $\frac{1}{4}$ , $\frac{1}{4}$ , Sec. <u>16</u> <u>8N 16E</u> T R	Clay	8	8
<u>8</u> miles <u>N</u> of <u>Meadison</u> (distance) (direction) (Nearest Town)	Clay	14	14
(3) Topography: <input checked="" type="checkbox"/> (Hilly) <input type="checkbox"/> (Flat) <input type="checkbox"/> (Level)	Brick	16	16
(4) Purpose of Well: <u>Domestic</u> (Domestic Irrigation, Municipal, Industrial, Other)	✓	42	42
Information upon completion of well:	✓	50	50
(1) Diameter <u>3</u> inches.	✓	62	62
(2) Total Depth <u>220</u> feet.	✓	62	62
(3) Water Level <u>80</u> feet below top of ground.	✓	85	85
(4) Cased to <u>147</u> , Size <u>3"</u>	Hard shale	105	105
(5) Screen: Size <input checked="" type="checkbox"/> Length <input checked="" type="checkbox"/>	✓	130	130
(6) Were any formations sealed against pollution? <input checked="" type="checkbox"/> yes, <input type="checkbox"/> no.	Hard shale	160	160
If YES depth of formation _____	✓	160	173
Why _____	Fine sand	173	185
Drillers Remarks: _____	Fine sand	185	220

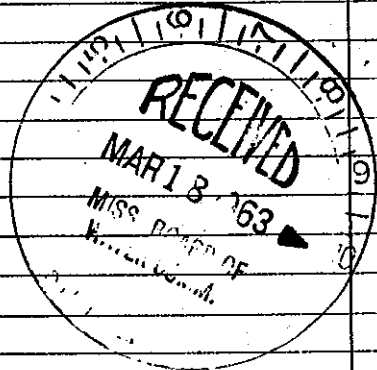

Well No.

(Use Back Side)

Retain this copy for your office files.