

LAUD.

MISSISSIPPI BOARD OF WATER COMMISSIONERS

C32

WATER WELL DRILLERS LOG

CODED

8-22-62

Date: 8-22, 1962, Driller: McDonald - Hice County Lauderdale

(Name)

(1) Owner of Land:	Description & Color of Materials Sand, Clay, Red Clay, Shell, etc.	Thick- ness Feet	Depth Feet
Phil McCallum (Name)	Clay	0	16
Lauderdale Miss. (Address)	M shale	16	48
(2) Location: 1/4, 1/4, Sec. 8, 16	H shale	48	90
miles _____, of _____	Soft Shale	90	100
(distance) _____ (direction) _____ (Nearest Town)	C sand	100	110
(3) Topography: _____	M sand	110	160
(Hilly) _____ (Flat) _____ (Level) _____			
(4) Purpose of Well: Domestic			
(Domestic Irrigation, Municipal, Industrial, Other)			

Information upon completion of well:


- (1) Diameter 4 inches.
- (2) Total Depth 160 feet.
- (3) Water Level 25 feet below top of ground.
- (4) Cased to 158, Size 2x4
- (5) Screen: Size 2", Length 7
- (6) Were any formations sealed against pollution?
_____ yes, _____ no.

If YES depth of formation _____

Why _____

Drillers Remarks: _____

CODED

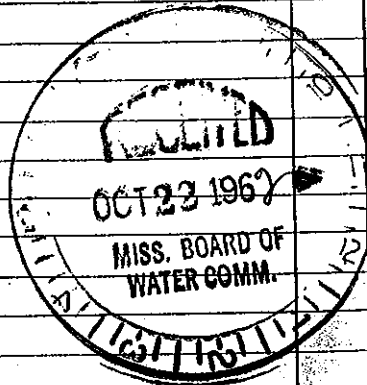

Well No.

(Use Back Side)

Mail this copy to Board of Water Commissioners 429 Miss. St. Jackson, Miss