

MISSISSIPPI BOARD OF WATER COMMISSIONERS

LAND
C33

WATER WELL DRILLERS LOG

CODED

Date: 9-12, 1967, Driller: McDonald Hill County: Lauderdale
(Name)

| | | | |
|--|---|-------------------|---------------|
| (1) Owner of Land: <u>James T. Garrett</u> (Name) <u>Rt # 4 Meidian</u> (Address) | Description & Color of Materials Sand, Clay, Red Clay, Shell, etc. | Thickness Feet | Depth Feet |
| | | <u>Clay</u> | <u>0</u> |
| (2) Location: <u>1/4</u> , <u>2, 5 16</u> Sec. <u>T. R.</u> _____ miles _____ of _____ (distance) (direction) (Nearest Town) | <u>B. Shale (Rock 110)</u> | <u>20</u> | <u>210</u> |
| | <u>B. Shale w/ Sand</u> | <u>210</u> | <u>240</u> |
| | <u>B. Shale</u> | <u>240</u> | <u>260</u> |
| | <u>Final Sand</u> | <u>260</u> | <u>300</u> |
| (3) Topography: <input checked="" type="checkbox"/> (Hilly) _____ (Flat) _____ (Level) | | | |
| (4) Purpose of Well: <u>Domestic</u> (Domestic Irrigation, Municipal, Industrial, Other) | | | |

Information upon completion of well:

(1) Diameter 3" inches.

(2) Total Depth 300 feet.


(3) Water Level 126 feet below top of ground.

(4) Cased to 147, Size 3"

(5) Screen: Size , Length

(6) Were any formations sealed against pollution?
_____ yes, no.

CODED

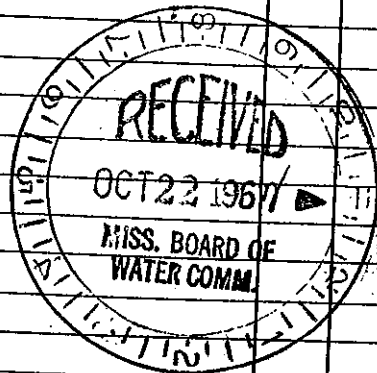

If YES depth of formation _____

Why _____

Drillers Remarks: _____

Well No.

(Use Back Side)

Mail this copy to Board of Water Commissioners 429 Miss. St. Jackson, Miss.