

LAUD.  
C 34

MISSISSIPPI BOARD OF WATER COMMISSIONERS

WATER WELL DRILLERS LOG

**CODED**

McDONALD & HILL, Inc.

1-21-63

Date: 1-21, 1963 Driller: P. O. Box 81 County: Lauderdale

Meridian, Mississippi

(1) Owner of Land: J. H. Plowman  
(Name)  
Bonita, Miss.  
(Address)

(2) Location: 1/4, 1/4, Sec 8, R 16  
15 miles N of Meridian  
(distance) (direction) (Nearest Town)

(3) Topography:  (Hilly)  (Flat)  (Level)

(4) Purpose of Well: Domestic  
(Domestic Irrigation, Municipal, Industrial, Other)

Description & Color of Materials Sand, Clay, Red Clay, Shell, etc.	Thick- ness Feet	Depth Feet
Clay	0	10
shale	10	45
Shale	45	85
Shale	35	100
Sand	100	120

Information upon completion of well:

(1) Diameter 2 inches.

(2) Total Depth 120 feet.

(3) Water Level 17 feet below top of ground.

(4) Cased to 115, Size 2

(5) Screen: Size #12, Length 3


(6) Were any formations sealed against pollution?  
 yes,  no.

**CODED**

If YES, depth of formation \_\_\_\_\_

Why \_\_\_\_\_

Drillers Remarks: \_\_\_\_\_

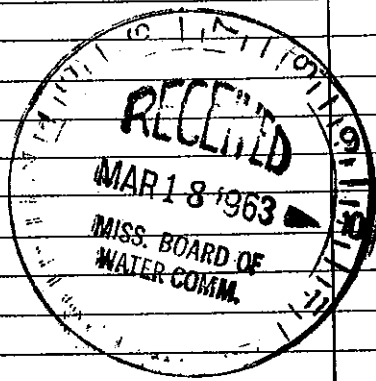

Well No.

(Use Back Side)