

MISSISSIPPI BOARD OF WATER COMMISSIONERS

WATER WELL DRILLERS LOG

CODED

C36
11-14-63

Date: 11/14, 1963, Driller: M. Donald & Hill County Lauderdale

(Name)


(1) Owner of Land: L.C. NOMAY
(Name)
R#1 MERIDIAN
(Address)
31 8 16
(2) Location: 1/4, 1/4, Sec. 8 T. 16 R. 1
_____ miles _____ of _____
(distance) (direction) (Nearest Town)
(3) Topography: (Hilly) (Flat) (Level)
(4) Purpose of Well: DOMESTIC
(Domestic Irrigation
Municipal, Industrial, Other)

Description & Color of Materials Sand, Clay, Red Clay, Shell, etc.	Thick- ness Feet	Depth Feet
CLAY	0	10
YELLOW SAND	10	20
SHALE	20	38
SHALE	38	170
SANDY	170	190
SHALE	190	202
ROCK	202	205
SHALE	205	220
ROCK	220	235
SHALE	225	240
SAND	240	260

Information upon completion of well:

(1) Diameter 4" inches.
(2) Total Depth 260' feet.
(3) Water Level 60' feet below top of ground.
(4) Cased to 150', Size 4"
(5) Screen: Size _____, Length _____
(6) Were any formations sealed against pollution?
_____ yes, _____ no.

CODED

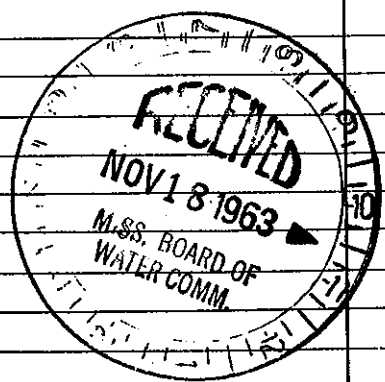

If YES depth of formation _____
Why _____
Drillers Remarks: _____

(Use Back Side)

Well No.