
۲,

County: <u>Vav Indall</u> Permit #: <u>M5 - 64-16887</u> Driller: <u>Mc Deviald - Hill</u> Date drilling completed: <u>9[10[11]</u> Mississippi Department Office of Land a P.O. Jackson (601)86	Priller's Log Aquifer: _ Int of Environmental Quality Aquifer: _ Ind Water Resources Well #: _ Box 2309 Well #: _ In, MS 39225 L. S. Elev 961- 5210 E-log #: _	or Office Use Only:
State Law requires that this report be prepared by the lic Department at the above address within 30 days of comp Information on Well Owner (Landowner if borchole is not for a water well) Owner Name Chav(15 Mailing Address: 105 OAK Monf Rd. <u>Starkrille MS 39759</u> City State Zip Code	ense holder responsible för the work a bletion of drilling of the well or boreho Well or Borehole Loc Latitude: <u>32°33 '51</u> " Longitu Method of Lat/Long (circle one): Conve USGS quad, Hand-held GPS, Sur NE 1/2 SU/2 Sec Twn B Distance Direction Neare of of	ole. cation de: <u>85°42,C4</u> ." ntional Survey, vey-grade GPS MRng / CFE
Telephone No. (M Hole depth: <u>340</u> Hole dian Community lopment: <u>116 per 1,000</u> Density Sonic Neutron Other:	o quellor s
Seismic SurveyOther (describ <u>If drilling is not related to water_well construction</u> Purpose of Well (check one): HomeIndustrial Public Suppl If a flowing well, method of flow regulation: ValveO Static Water Level:feet above or below (eircle one) Method of Measurement (circle one)steel tapeelectric tape	m, skip the remainder of this duck yIrrigation Fish CultureOther: Other (describe) land surface Date measured:	of u
Well depth: <u>340</u> Well grouted to a depth offcct Typ Casing length: <u>//60</u> feet Casing diameter: <u>4</u> Screen length: <u>//00</u> feet Screen diameter: <u>2</u> Screen slot size: <u>0(2</u> inches Setting depth: From Type of completion (circle all applicable): Gravel packed Unde Other (describe): Top of lap pipe or reduction in casing: <u>126</u> feet. If r	inches Type of casing: <u>PVC</u> inches Type of screen: <u>PVC</u> <u>280</u> feet to <u>340</u>	feet satural Development
		OLWR-SWR-1A (04/08

forked 9/17/11

063



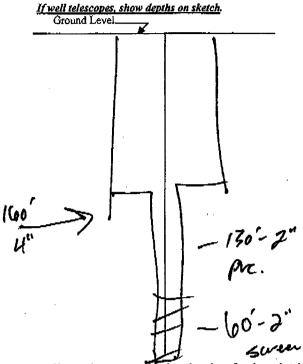

Description of form	ations encountered must be provided for all
wells and boreholes,	unless specifically exempted by regulations

Description of Formations Encountered		o (depth)
Per Clay	Ground Level	20
Sample Strike	2	50
Shall	30	80
Liquite	80	85
SIAND	85	160
shale	100	110
Soudy shalp	110	140
shale	140	160
Sandy Shelle	160	180
Shalf	180	225
Sandy Shall	275	210
SAND	270	341
	-	

If more than one screen, show location of each on sketch

Sketch the property layout and include the following: 1) the well location; 2) any permanent structures on the property that may aid in locating the well; 3) any roads, power lines, or other items that may aid in locating the property and the well; 4) a north arrow.

Balvenile General Stone. Daleville Prismatic It 1.6 mil 391 o-well Charles Clay Landowner Name:

Form: OLWR-SWR-1A (04/08)

I certify that the well/borehole was drilled, constructed, and completed in accordance with all applicable requirements of the Mississippi Department of Environmental Quality and the Mississippi Department of Health regulations, if applicable and state

laws. HILL HAROLD Date

Print Name of Responsible Licensee and License No.

Signature of Licensee

.

. .

.

.

	STATE WELL RE	PORT			
County: Cangeroule	Part 2	.	For Office Use Only:		
Permit #: Mis:	Pump Installer's Completion Report Mississippi Department of Environmental Quality		Aquifer;		
Driller:	Office of Land and Water Resources				
Date completed: 8 10 11	P.O. Box 2309 Jackson, MS 39225		Well #: <u>C63</u>		
Date completed:	(601)961-5210		Elevation:		
Copy information from block on Part 1	(601)961-5228 (fax)				
This part of the report must be completed by a licensed water well contractor or a licensed pump installer. A copy of Part I of the report must be attached and both parts filed with the Department at the above address within 30 days of well completion.					
Well Owner Information			ocation		
Owner Name: Chawles clayto	175h Latitude: <u>32-33-51</u>		ongitude: <u>88 - 4 2 - 64</u> (
Mailing Address: 105 OHK Mont	Method of Lat/Long (check one): Conventional Survey_		: Conventional Survey,		
	USGS qua	i, Hand-held G	PS, Survey-grade GPS		
Stankville Ms City State	<u>3975</u> 9 <u>NE</u> 4	NE 14 5W 14 Sec 10 T SAVR 16F			
City State	Distance	Direction	Nearest Town		
Telephone No. ()	M	iles of _			
Ритр Туре	t	Powe	r Type		
Circle one			le one		
Air Lift Jet Subm	ersible Dicsel Engi	ne Gasoline I	Engine Natural Gas		
Bucket Piston Turbi	ne Electric Mo	Hand	Tractor PTO		
Centrifugal Rotary Flow	ing Well Windmill	Other (sp	ecify):		
Other (specify):	Horse Powe	r Rating of Motor: _	<u>_5</u> #p		
Date Pump Installed: 9/18/11		th: 140			
Rated Pump Capacity: Gallon	s Per Minute Number of	Stages: /	/		
Pump Test Data	· · · · · · · · · · · · · · · · · · ·	Method of Meas	uring Water Level		
Date Well Tested: 8/18/11		Circ	le one		
ía /	Land Surface	Electric Measu	ring Line Steel Tape		
Pumping Water Level (B):Feet Below	Other (spec	ify):			
		well, measured shut	in head:feet		
	s Per Minute Well yielde	a <u>50</u>	GPM with a drawdown of		
Duration of Pump Test (minimum 4 hours):	hours55	feet after	hours of pumping		
I HEREBY CERTIFY that the above statements ar <u>HAROLD H</u> /I <u>FFO</u> Print Name of Pump Installer and License No. (if a	-8	frature of Pump Inst	Aller Form: OLWR-SWR-1B (04/08)		