

MISSISSIPPI BOARD OF WATER COMMISSIONERS

WATER WELL DRILLERS LOG

1-20-60

Date: Sept. 20, 1960, Driller: Terry Drilling Co. County, Lauderdale
Robert Hall - Driller

(1) Owner of Land:	Description & Color of Materials Sand, Clay, Red Clay, Shell, etc.	Thick- ness Feet	Depth Feet
Capehart Housing Project (Name) Lizelia, Miss	Red Clay + yellow sand	0	29'
8 N 16 E (Address)	Gray mud	22'	78'
(2) Location: 1/4, 1/4, Sec. 3 T. R.	Coarse gray sand	78'	102'
2 miles East of Lizelia (distance) (direction) (Nearest Town)			
(3) Topography: (Hilly) (Flat) (Level)			
(4) Purpose of Well: For Construction (Domestic Irrigation, Municipal, Industrial, Other)			

Information upon completion of well:

(1) Diameter 2 inches.

(2) Total Depth 107 feet.

(3) Water Level 10 feet below top of ground.

(4) Cased to 102', Size 2"


(5) Screen: Size 2", Length 5"

(6) Were any formations sealed against pollution?
 _____ yes, no.

If YES depth of formation _____

Why set straight well

Drillers Remarks: _____

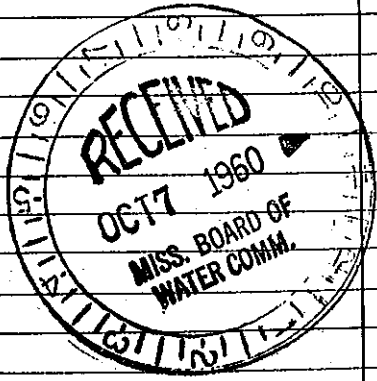

(Use Back Side)

Mail this copy to Board of Water Commissioners 429 Miss. St. Jac