

LAUD. MISSISSIPPI BOARD OF WATER COMMISSIONERS

D5

12-21-64

WATER WELL DRILLERS LOG

Date: 12-21, 1964, Driller: Bob Williams County Lauderdale

(Name)

(1) Owner of Land: Cal Diebert (Name)

Lauderdale, Miss. (Address)

Dalewood Shore Lake Lot # 89 (2) Location: 1/4, 1/4, Sec. 25 T8 R17,

1 miles South of Lauderdale (distance) (direction) (Nearest Town)

(3) Topography: hilly (Hilly) (Flat) (Level)

(4) Purpose of Well: Domestic (Domestic Irrigation Municipal, Industrial, Other)

Description & Color of Materials Sand, Clay, Red Clay, Shell, etc.

Thick-ness Feet

Depth Feet

White clay 20

1-20

White sand 15

20-35

Blue clay 30

35-65

gray sand 20

65-85

Blue clay mixed sand 20

85-105

Information upon completion of well:

(1) Diameter 2 inches.

(2) Total Depth 105 feet.

(3) Water Level 27 feet below top of ground.

(4) Cased to 78, Size 2"

(5) Screen: Size 2" 12 slot, Length 5'


(6) Were any formations sealed against pollution?

yes, no.

If YES depth of formation

Why

Drillers Remarks:

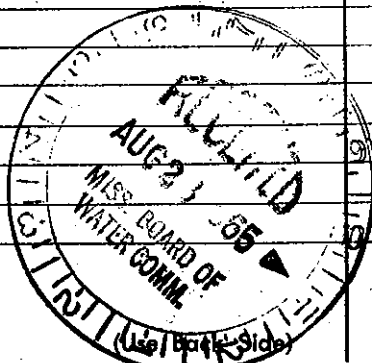

Well No.

Mail this copy to Board of Water Commissioners 429 Miss. St. Jackson, Miss