

LAUD.

MISSISSIPPI BOARD OF WATER COMMISSIONERS

D 12
9-8-60

WATER WELL DRILLERS LOG

Q 301

Date: Sept. 8, 1960, Driller: Berry Drilling Co. County Lauderdale
(Name Robert Hall - Driller)

	Description & Color of Materials Sand, Clay, Red Clay, Shell, etc.	Thick- ness Feet	Depth Feet
(1) Owner of Land: <u>Navy Base</u> (Name) <u>Lauderdale, Miss</u> (Address)	<u>Red Clay</u>	<u>0</u>	<u>15'</u>
	<u>Blue mud</u>	<u>15'</u>	<u>31'</u>
	<u>Yellow sand</u>	<u>31'</u>	<u>44'</u>
	<u>Blue mud</u>	<u>44'</u>	<u>49'</u>
	<u>fine white sand</u>	<u>49'</u>	<u>66'</u>
	<u>red sand</u>	<u>66'</u>	<u>109'</u>
	<u>White coarse sand</u>	<u>109'</u>	<u>130'</u>
	<u>soft sand rock</u>	<u>130'</u>	<u>133'</u>

(2) Location: 1/4, 1/4, Sec. T R
3 miles west, of Lauderdale
(distance) (direction) (Nearest Town)

(3) Topography: (Hilly) (Flat) (Level)

(4) Purpose of Well: Communication tower
(Domestic Irrigation, Municipal, Industrial, Other)

Information upon completion of well:

(1) Diameter 2 inches.

(2) Total Depth 133 feet.

(3) Water Level 60' 7 3/4 feet below top of ground.

(4) Cased to 123, Size 2"


(5) Screen: Size 2", Length 10'

(6) Were any formations sealed against pollution?
no

If YES depth of formation _____

Why Made straight well

Drillers Remarks: _____

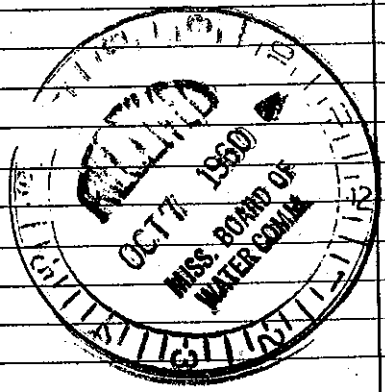

Well No.

(Use Back Side)