

LAVO.  
D24

MISSISSIPPI BOARD OF WATER COMMISSIONERS

WATER WELL DRILLERS LOG

12-18-64

Date: 12/18, 1964, Driller: Bob Williams County Lauderdale  
(Name)

(1) Owner of Land: <u>N. F. Inby</u> (Name) <u>Lauderdale, Miss.</u> (Address) <u>Polewood Shores Lot # 1117</u>	Description & Color of Materials Sand, Clay, Red Clay, Shell, etc.	Thick- ness Feet	Depth Feet
(2) Location: <u>1/4, 1/4, Sec. 26 T. 8N R. 17E</u> <u>1</u> miles <u>South</u> of <u>Lauderdale</u> (distance) (direction) (Nearest Town)	<u>Red sand</u>	<u>70</u>	<u>1-70</u>
(3) Topography: <u>Hilly</u> (Hilly) (Flat) (Level)	<u>Blue clay</u>	<u>10</u>	<u>70-80</u>
(4) Purpose of Well: <u>Domestic</u> (Domestic Irrigation Municipal, Industrial, Other)	<u>gray sand</u>	<u>55</u>	<u>80-135</u>

Information upon completion of well:

(1) Diameter 2 inches.

(2) Total Depth 135 feet.

(3) Water Level 62 feet below top of ground.

(4) Cased to 130, Size 2"


(5) Screen: Size 2" 13 Slot, Length 5'

(6) Were any formations sealed against pollution?  
 yes,  no.

If YES depth of formation \_\_\_\_\_

Why \_\_\_\_\_

Drillers Remarks: \_\_\_\_\_

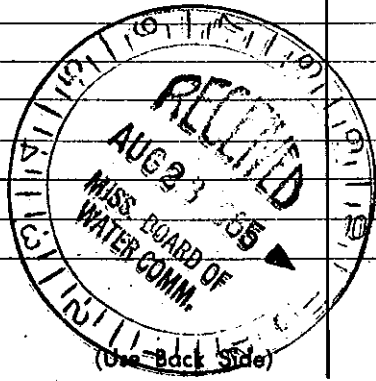

Well No. \_\_\_\_\_

Retain this copy for your office files.