

LAUD. WATER WELL DRILLERS LOG

Date: 6-2, 1965, Driller: Bob Wilkinson County Laud.
 6-2-65 (Name)

(1) Owner of Land:	Description & Color of Materials Sand, Clay, Red Clay, Shell, etc.	Thick- ness Feet	Depth Feet
<u>Bobby Rutledge</u> (Name) <u>Lauderdale, Miss.</u> (Address)	<u>white sand</u>	<u>20</u>	<u>1-20</u>
(2) Location: <u>1/4</u> , <u>1/4</u> , Sec. <u>25 8N 17E</u> T. <u>R.</u>	<u>Blue clay</u>	<u>50</u>	<u>20-70</u>
<u>1</u> miles <u>south</u> , of <u>Laud.</u> (distance) (direction) (Nearest Town)	<u>gray sand</u>	<u>20</u>	<u>70-90</u>
(3) Topography: <u>hilly</u> (Hilly) (Flat) (Level)			
(4) Purpose of Well: <u>domestic</u> (Domestic Irrigation Municipal, Industrial, Other)			

Information upon completion of well:

(1) Diameter 2 inches.

(2) Total Depth 90 feet.

(3) Water Level 40 feet below top of ground.

(4) Cased to 84, Size 2"


(5) Screen: Size 6ft 2", Length _____

(6) Were any formations sealed against pollution?
 _____ yes, no.

If YES depth of formation _____

Why _____

Drillers Remarks: _____

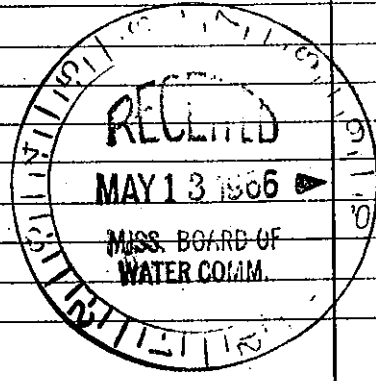

(Use Back Side)

Well No.

Mail this copy to Board of Water Commissioners 429 Miss. St. Jackson, Miss