

Lauderdale MISSISSIPPI BOARD OF WATER COMMISSIONERS

WATER WELL DRILLERS LOG

D29
7-66
Date: 7/17, 1966

Driller: TERRY WELLS Co. County: LAUD
(Name)

(1) Owner of Land:	Description & Color of Materials Sand, Clay, Red Clay, Shell, etc.	Thick- ness Feet	Depth Feet
Henry Charlton (Name)	CLAY, YELLOW	15	
Lauderdale, Miss (Address)	SAND & SHALE	15-40	
(2) Location: 35 1/4, 35 1/4, Sec. 25 T. 8 N. R. 17 E.	SHALE	40	60
1 miles S of LAUDERDALE (distance) (direction) (Nearest Town)	SAND	60	85
(3) Topography: (Hilly) (Flat) (Level)	SHALE	85	100
(4) Purpose of Well: Domestic (Domestic Irrigation, Municipal, Industrial, Other)	SAND	100	110


Information upon completion of well:

- (1) Diameter 2 inches.
- (2) Total Depth 110 feet.
- (3) Water Level 18 feet below top of ground.
- (4) Cased to 105, Size 2.
- (5) Screen: Size 2, Length 5'.
- (6) Were any formations sealed against pollution?
_____ yes, _____ no.

If YES depth of formation _____

Why _____

Drillers Remarks: _____

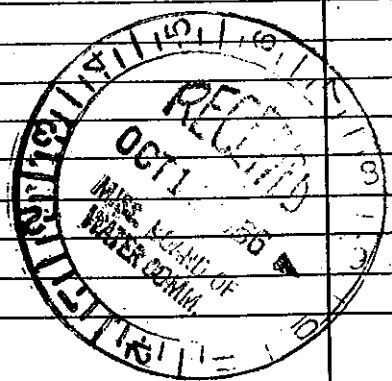

(Use Back Side)

Well No.

Mail this copy to Board of Water Commissioners 429 Miss. St. Jackson, Miss.