


Lauderdale
D32
4-67

MISSISSIPPI
BOARD OF WATER COMMISSIONERS
416 North State Street
Jackson, Mississippi 39201

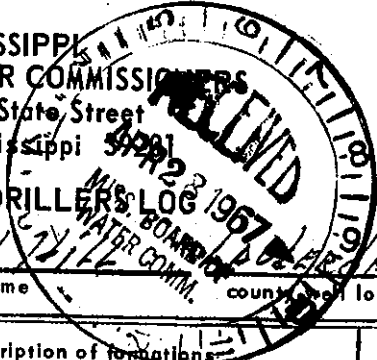

WATER WELL DRILLERS LOG
firm name: 1967 McDONALD
county located: LAUDERDALE

4.26
date well completed

LANDOWNER: BRYAN LAUDERDALE
(mailing address)

description of formations encountered	from to	
CLAY	0	18
SHALE	18	32
SAND ST SHALE	32	51
SHALE	51	98
SAND	98	116

WELL LOCATION:
sec. 36 T. 8 N R. 18 E
S W
2 miles SEAST of LAUDERDALE
(distance) (direction) (nearest town)

WELL PURPOSE: HOME
(home, irrigation, municipal, industrial)

WELL COMPLETION DATA:

- (1) diameter (inches) 3 7/8 TEST HOLE
- (2) total depth (feet) 115
- (3) static water level (feet) 22 (below above top of ground)
- (4) casing GALV, 110'
(material) (depth)
2"
(size) If telescope see back.
- (5) screen 5', 110'
(length) (depth to top)
2, BRASS
(size) (material)
- (6) pump 1/2, 10
(HP) (yield gpm)
230
(type power)
- (7) electric log NO
(yes or no)
(organization running log)
- (8) how well bottom plugged VALVE

DRILLERS REMARKS: