

LAUD. MISSISSIPPI BOARD OF WATER COMMISSIONERS

D34

6-30-60

June 30

WATER WELL DRILLERS LOG

Date: ~~July 1~~, 1960, Driller: Berry Drilling Co. County Landredak

(Name) Robert Hall Driller

(1) Owner of Land: <u>Mc Cain Jory Bass</u> (Name)	Description & Color of Materials Sand, Clay, Red Clay, Shell, etc.	Thick- ness Feet	Depth Feet
<u>Near Meridian Miss.</u> (Address)	<u>Red + yellow clay</u>	<u>0-40'</u>	
(2) Location: <u>1/4, 1/4, Sec 9</u> <u>SNITE</u> T. R.	<u>Blue mud</u>	<u>40-70'</u>	
(3) Topography: <u>12</u> miles <u>North</u> of <u>Meridian</u> (distance) (direction) (Nearest Town)	<u>Coarse heavy sand</u>	<u>70-130'</u>	
(4) Purpose of Well: <u>Construction Work</u> (Domestic Irrigation Municipal, Industrial, Other)			

Information upon completion of well:


- (1) Diameter 4 inches.
- (2) Total Depth 130 feet.
- (3) Water Level 15' feet below top of ground.
- (4) Cased to 85', Size 4"
- (5) Screen: Size 2 1/2", Length 10'
- (6) Were any formations sealed against pollution?
no.

If YES depth of formation _____

Why Surface casing set in sand

Drillers Remarks:

Well cased from 85'
to top of strainer with
2 1/2" Pipe

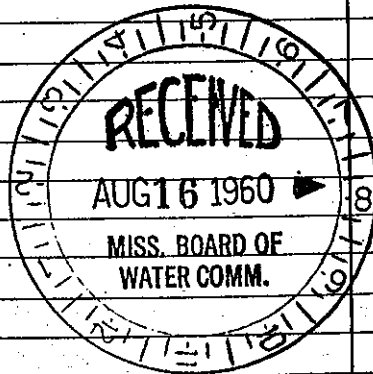

Well No.

(Use Back Side)

this copy to Board of Water Commissioners 429 Miss. St. Jackson, Miss.