

BOARD OF WATER COMMISSIONERS

LAUD. WATER WELL DRILLERS LOG

D36

Date: 2. 12-1-62, Driller: McDONALD HILL County: AUDEBON

(Name)

(1) Owner of Land:	Description & Color of Materials Sand, Clay, Red Clay, Shell, etc.	Thick- ness Feet	Depth Feet
MRS RANNIE JACKSON (Name)	CLAY	0	20
LOCKHART MISS (Address)	SAND	20	35
(2) Location: 1/4, 1/4, Sec. 28 ^{8N 17E} T R	SHALE	35	70
14 miles NEAST, of AMERICAN (distance) (direction) (Nearest Town)	SANDY SHALE	70	95
(3) Topography: X (Hilly) (Flat) (Level)	FINE SAND	95	140
(4) Purpose of Well: DOMESTIC (Domestic Irrigation Municipal, Industrial, Other)	SAND NO 12	140	157


Information upon completion of well:

- (1) Diameter 2' inches.
- (2) Total Depth 157' feet.
- (3) Water Level 54' feet below top of ground.
- (4) Cased to 149', Size 2"
- (5) Screen: Size 2", Length 5'
- (6) Were any formations sealed against pollution?
_____ yes, _____ no.

If YES depth of formation _____

Why _____

Drillers Remarks: _____

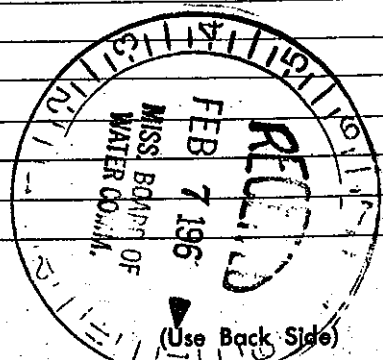

Well No. _____

Mail this copy to Board of Water Commissioners 429 Miss. St. Jackson, Miss.