

MISSISSIPPI BOARD OF WATER COMMISSIONERS

LAUD.  
D 37  
3-16-62

WATER WELL DRILLERS LOG

Date: 3/16, 1962, Driller: McDonald + Hill County Lauderdale  
(Name)

(1) Owner of Land: Bill Spruice  
(Name)  
Lauderdale  
(Address)

(2) Location: 1/4, 1/4, Sec. 23 8N17E  
T. R.

       miles        of         
(distance) (direction) (Nearest Town)

(3) Topography: Flat  
(Hilly) (Flat) (Level)

(4) Purpose of Well: Domestic  
(Domestic Irrigation  
Municipal, Industrial, Other)

Description & Color of Materials Sand, Clay, Red Clay, Shell, etc.	Thick- ness Feet	Depth Feet
Clay	0	8
Clay + Sandy str	8	28
medul + sand str	28	38
medium sand	38	50

Information upon completion of well:

(1) Diameter 2 inches.

(2) Total Depth 50 feet.

(3) Water Level 8 feet below top of ground.

(4) Cased to 48, Size 2


(5) Screen: Size 2", Length 5 ft.

(6) Were any formations sealed against pollution?  
       yes,        no.

If YES depth of formation       

Why       

Drillers Remarks:       

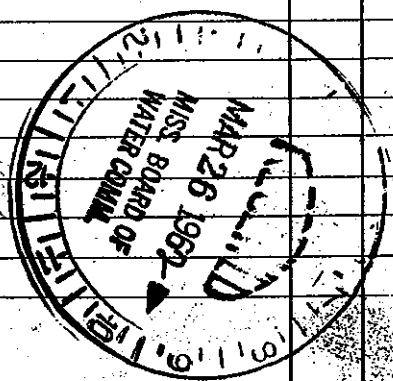

(Use Back Side)

Well No.

Mail this copy to Board of Water Commissioners 429 Miss. St. Jackson, Miss.