

MISSISSIPPI BOARD OF WATER COMMISSIONER

LAUD.
D38
1-21-63

WATER WELL DRILLERS LOG

Date: 1-21, 1963, Driller: Mr. Donald - Hill Lauderdale
(Name)

(1) Owner of Land: Jamie Ratcliff
(Name)
Lauderdale, Miss.
(Address)

(2) Location: $\frac{1}{4}$, $\frac{1}{4}$, Sec. 13 T. 17E
17 miles N of Meriden
(distance) (direction) (Nearest Town)

(3) Topography: _____
(Hilly) (Flat) (Level)

(4) Purpose of Well: Domestic
(Domestic Irrigation
Municipal, Industrial, Other)

Description & Color of Materials Sand, Clay, Red Clay, Shell, etc.	Thick- ness Feet	Depth Feet
<u>Clay</u>	<u>0</u>	<u>10</u>
<u>Shale</u>	<u>10</u>	<u>22</u>
<u>Sand</u>	<u>22</u>	<u>33</u>
<u>Shale</u>	<u>33</u>	<u>50</u>
<u>Sandy</u>	<u>50</u>	<u>70</u>
<u>Shale</u>	<u>70</u>	<u>90</u>
<u>Sand</u>	<u>90</u>	<u>107</u>

Information upon completion of well:

(1) Diameter 2 inches.

(2) Total Depth 107 feet.

(3) Water Level 12 feet below top of ground.

(4) Cased to 100, Size 2


(5) Screen: Size 12, Length 3

(6) Were any formations sealed against pollution?
_____ yes, no.

If YES depth of formation _____

Why _____

Drillers Remarks: _____

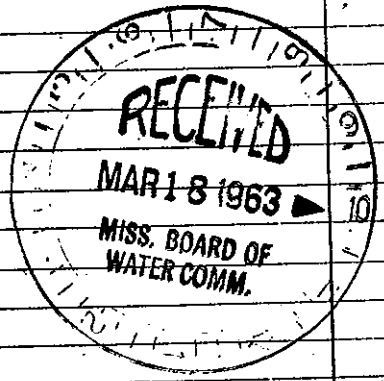

Well No.

(Use Back Side)

Retain this copy for your office files.