

D 40

WATER WELL DRILLERS LOG


Date: 4-14-64, 1964, Driller: Jerry County Laud
(Name)

(1) Owner of Land:	Description & Color of Materials Sand, Clay, Red Clay, Shell, etc.	Thick- ness Feet	Depth Feet
<u>C. L. Davidson</u> <small>(Name)</small> <u>Lauderdale, Miss</u> <small>(Address)</small>	<u>yellow mud</u>	<u>0</u>	<u>21</u>
(2) Location: <u>1/4</u> , <u>1/4</u> , Sec <u>13</u> <u>T</u> <u>R</u>	<u>Sandy shale</u>	<u>21</u>	<u>105</u>
<u>15</u> miles <u>N</u> of <u>McN</u> <small>(distance) (direction) (Nearest Town)</small>			
(3) Topography: <input checked="" type="checkbox"/> <u>✓</u> <small>(Hilly) (Flat) (Level)</small>			
(4) Purpose of Well: <u>Domestic</u> <small>(Domestic Irrigation Municipal, Industrial, Other)</small>			

Information upon completion of well:

- (1) Diameter 2 inches.
- (2) Total Depth 105 feet.
- (3) Water Level 30 feet below top of ground.
- (4) Cased to 105, Size 2.
- (5) Screen: Size 2", Length 6'.
- (6) Were any formations sealed against pollution?
 yes, no.

If YES depth of formation _____
 Why _____
 Drillers Remarks: _____

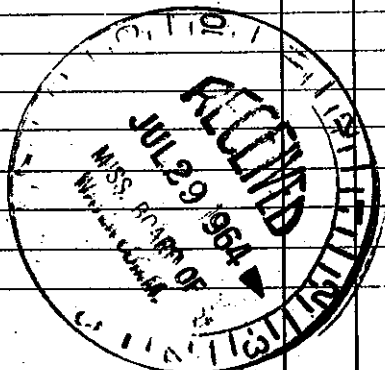

(Use Back Side)

Well No.

Retain this copy for your office files.