

LAUD  
D 46  
4-1-65

MISSISSIPPI BOARD OF WATER COMMISSIONERS

WATER WELL DRILLERS LOG

Date: 4-1, 1965, Driller: TERRY County LAUD,  
(Name)

	Description & Color of Materials <small>(Sand, Clay, Red Clay, Shell, etc.)</small>	Thick- ness Feet	Depth Feet
(1) Owner of Land: <u>MRS MATTIMORE MEYERS</u> <small>(Name)</small> <u>2622 - PSD MEN</u> <small>(Address)</small>	<u>yellow clay &amp; sand</u>	<u>25'</u>	<u>25'</u>
(2) Location: <u>1/4</u> , <u>1/4</u> , Sec. <u>13</u> <u>SW</u> <u>17E</u> <small>(distance) (direction) (Nearest Town)</small>	<u>Blue clay</u>	<u>15'</u>	<u>40'</u>
(3) Topography: <input checked="" type="checkbox"/> (Hilly) <input type="checkbox"/> (Flat) <input type="checkbox"/> (Level)	<u>Coarse sand</u>	<u>30'</u>	<u>70'</u>
(4) Purpose of Well: <u>DOMESTIC</u> <small>(Domestic, Irrigation, Municipal, Industrial, Other)</small>	<u>Blue dirt</u>	<u>10'</u>	<u>80'</u>
	<u>Coarse sand</u>	<u>29'</u>	<u>109'</u>


Information upon completion of well:

- (1) Diameter 2" inches.
- (2) Total Depth 109 feet.
- (3) Water Level 18' feet below top of ground.
- (4) Cased to 104', Size 2".
- (5) Screen: Size 2, Length 5'.
- (6) Were any formations sealed against pollution?  
 yes,  no.

If YES depth of formation \_\_\_\_\_

Why \_\_\_\_\_

Drillers Remarks: \_\_\_\_\_

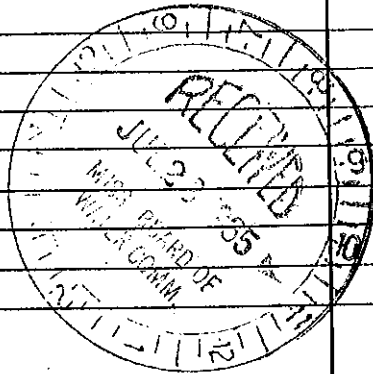

(Use Back Side)

Well No. \_\_\_\_\_

Mail this copy to Board of Water Commissioners 429 Miss. St. Jackson, Miss.