

LAUD.

MISSISSIPPI

D 51

11-11-65

WATER WELL DRILLERS LOG

Zerry Drilling

Date: 11/11, 1965, Driller: SEABROUGH County LAUD

(Name)

(1) Owner of Land: HAROLD DeBOSE
(Name)

DALEWOOD LAKE, LAUDERDALE
(Address)

(2) Location: 1/4, 1/4, Sec. 23 NE
T R

12 miles NORTH of MDN
(distance) (direction) (Nearest Town)

(3) Topography: (Flat)
(Hilly) (Flat) (Level)

(4) Purpose of Well: DOMESTIC
(Domestic Irrigation, Municipal, Industrial, Other)

Description & Color of Materials
Sand, Clay, Red Clay, Shell, etc.

Thick-
ness
Feet

Depth
Feet

FINE SAND top to
bottom of well

Information upon completion of well:

(1) Diameter 2" inches.

(2) Total Depth 109 feet.

(3) Water Level 16 feet below top of ground.

(4) Cased to 103, Size 2"

(5) Screen: Size 6'2", Length _____


(6) Were any formations sealed against pollution?

_____ yes, _____ no.

If YES depth of formation _____

Why _____

Drillers Remarks: _____

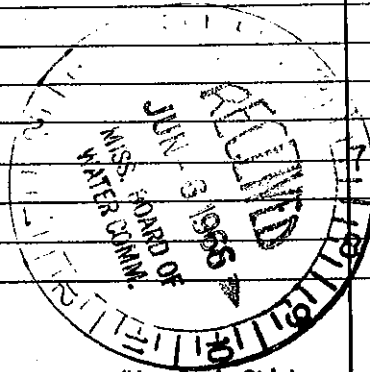

(Use Back Side)

Well No.

Retain this copy for your office files.