

LAUD. MISSISSIPPI BOARD OF WATER COMMISSIONERS

~~H25~~ D52
9-6-65

WATER WELL DRILLERS LOG

Date: 9/6, 1965, Driller: Jerry Drilling
Searbrough County LAUD
(Name)

(1) Owner of Land:	Description & Color of Materials Sand, Clay, Red Clay, Shell, etc.	Thick- ness Feet	Depth Feet
Q.C. ENGELL (Name)			
MARION, MISS (Address)	yellow clay & sand	0	31
(2) Location: 1/4, 1/4, Sec. 25 8N 17E T. R.	SANDY shale	31	65
_____ miles _____ of _____ (distance) (direction) (Nearest Town)	good white sand	65	110
(3) Topography: _____ (Hilly) (Flat) (Level)			
(4) Purpose of Well: DOMESTIC (Domestic Irrigation Municipal, Industrial, Other)			

Information upon completion of well:

(1) Diameter 2" inches.

(2) Total Depth 109 feet.

(3) Water Level 18 feet below top of ground.

(4) Cased to 103, Size 2"


(5) Screen: Size 2", Length 6'

(6) Were any formations sealed against pollution?
_____ yes, _____ no.

If YES depth of formation _____

Why _____

Drillers Remarks: CAMP AT
DALEWOOD LAKE

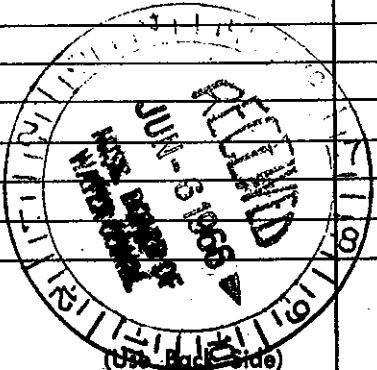

Well No.

Mail this copy to Board of Water Commissioners 429 Miss. St. Jackson, Miss.