

LAUDERDALE
 D 54
 8-67

MISSISSIPPI
 BOARD OF WATER COMMISSIONERS
 416 North State Street
 Jackson, Mississippi 39201
 WATER WELL DRILLERS LOG

8-7-67 date well completed 1967 TERRY DRILLING firm name LAUD county well located


LANDOWNER:
 Bill Brown
 Rt 2 Lauderdale
 (mailing address)

description of formations encountered	from	to
Yellow Clay & Sand	0	55
Blue Shale & Sand	55	85
Shale	85	185
Sandy Shale	185	215
Sand	215	262

WELL LOCATION:
 sec. 32 T. 8 N. R. 17 E.
 S W
 (distance) miles of COCKHART (direction) (nearest town)

WELL PURPOSE: HOME
 (home, irrigation, municipal, industrial)

- WELL COMPLETION DATA:
- (1) diameter (inches) 4
 - (2) total depth (feet) 262'
 - (3) static water level (feet) 140 below top of ground.
 - (4) casing 4" Pvc, 212' (material) (depth)
 2" (size) If telescope see back.
 - (5) screen 10' 252' (length) (depth to top)
 2" Stainless Steel (size) (material)
 - (6) pump 1 HP 15 gpm (HP) (yield gpm)
 SUBMERSA (type power)
 - (7) electric log No (yes or no)
 (organization running log)
 - (8) how well bottom plugged Wash Valve

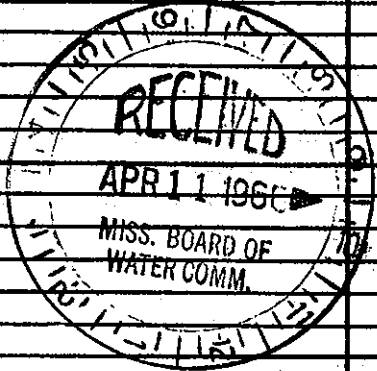

DRILLERS REMARKS:
 10' 12 SLOT STRAINER